

MISSISSIPPI DEPARTMENT OF NATURAL RESOURCES

Bureau of Land and Water Resources

Southport Mall

P.O. Box 10631

Jackson, Mississippi 39209

WATER WELL DRILLERS LOG

TATE
M 2002

HICKS WELL CO.
Rt. 1 Box 157
Senatobia, MS 38668

Tate

6/28 1984
date well completed

county well located

LANDOWNER: <u>Donald Walker</u> <u>Rt. 2</u>	description of formations encountered	from	to
<u>Senatobia, MS 38668</u> (mailing address)	<u>Red Clay</u>	<u>0</u>	<u>20</u>
WELL LOCATION: sec. <u>18</u> T <u>6</u> N R <u>7</u> E <u>3</u> miles <u>S</u> of <u>Senatobia</u> (distance) (direction) (nearest town)	<u>Red Sand</u>	<u>20</u>	<u>50</u>
WELL PURPOSE: <u>Home</u> (home, irrigation, municipal, industrial)	<u>Gravel</u>	<u>50</u>	<u>80</u>
WELL COMPLETION DATA: (1) diameter (inches) <u>4</u> (2) total depth (feet) <u>130</u> (3) static water level (feet) <u>60</u> ^{below} / _{above} top of ground. (4) casing <u>PVC</u> , <u>130</u> , (material) (depth) <u>4"</u> (size) If telescope see back. (5) screen <u>10'</u> , <u>120'</u> (length) (depth to top) <u>2 1/2</u> <u>PVC</u> (size) (material) (6) pump <u>1/2</u> , <u>10</u> (HP) (yield gpm) <u>220V</u> (type power) (7) electric log <u>No</u> (yes or no) (organization running log) (8) how well bottom plugged <u>Cap</u>	<u>White Sand</u>	<u>80</u>	<u>130</u>


DEPT. OF NATURAL RESOURCES
BUREAU OF LAND & WATER RESOURCES

JUL 10 1984
RECEIVED

DRILLERS REMARKS:

If well telescopes please sketch and show depths.

GROUND LEVEL

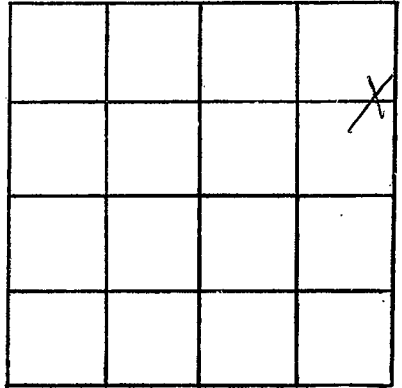

SECTION 18

Please indicate well location X.

ADDITIONAL INFORMATION

If more than one screen,
show locations of each on sketch.