

MISSISSIPPI DEPARTMENT OF NATURAL RESOURCES

Bureau of Land and Water Resources

Southport Mall

P.O. Box 10631

Jackson, Mississippi 39209

WATER WELL DRILLERS LOG

M 2003
Tate
7-19-85

7-19 1985 HICKS WELL COMPANY date well completed
 Rt. 1 - Box 157 HI. 1 - Box name
 Tate county well located

LANDOWNER: <u>Robby Strickland</u>	Senarobia, MISS.	description of formations encountered	from	to
<u>Rt #1</u>		<u>Red clay</u>	<u>0</u>	<u>10</u>
<u>Senarobia MS 38668</u> (mailing address)		<u>Red Sand</u>	<u>10</u>	<u>30</u>
WELL LOCATION:		<u>white clay + Sand</u>	<u>30</u>	<u>80</u>
sec. <u>1</u> T. <u>6</u> N. R. <u>7</u> E		<u>white Sand</u>	<u>80</u>	<u>125</u>
<u>4</u> miles <u>SE</u> of <u>New Town</u>				
(distance) (direction) (nearest town)				

WELL PURPOSE: Home
 (home, irrigation, municipal, industrial)

WELL COMPLETION DATA:

- (1) diameter (inches) 4"
- (2) total depth (feet) 125'
- (3) static water level (feet) 80 ^{below} _{above} top of ground.
- (4) casing PVC, 115'
 (material) (depth)
4" if telescope see back.
 (size)
- (5) screen 10', 115'
 (length) (depth to top)
- (6) pump 1/2, 10
 (HP) (yield gpm)
220 V
 (type power)
- (7) electric log NO
 (yes or no)

(organization running log)

(8) how well bottom plugged cap


DRILLERS REMARKS:

RECEIVED
 OCT 17 1985

Department of Natural Resources
 Bureau of Land & Water Resources

If well telescopes please sketch and show depths.

GROUND LEVEL

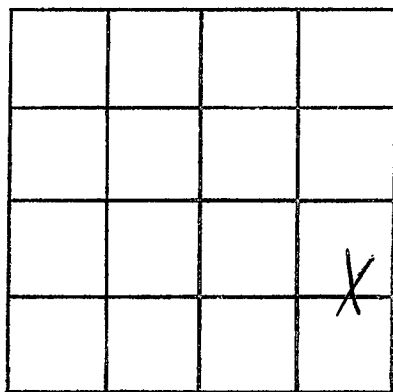

SECTION 1

Please indicate well location X.

ADDITIONAL INFORMATION

If more than one screen,
show locations of each on sketch.