

MISSISSIPPI DEPARTMENT OF NATURAL RESOURCES

Bureau of Land and Water Resources

Southport Mall

P.O. Box 10631

Jackson, Mississippi 39209

WATER WELL DRILLERS LOG

HICKS WELL COMPANY

RT. 1 BOX 157  
firm name  
SENATORIA, MISS

Tate  
county well located

TATE  
M 2004

8-5-1985  
date well completed

LANDOWNER: Lovell Webb  
RD # 1 Box 323  
Senatoria MS 38668  
(mailing address)

WELL LOCATION:

sec. 12 T. 6 N. R. 7 E  
S W  
1/2 miles N of Gravel Springs  
(distance) (direction) (nearest town)

WELL PURPOSE: Home  
(home, irrigation, municipal, industrial)

WELL COMPLETION DATA:

- (1) diameter (inches) 4"
- (2) total depth (feet) 155'
- (3) static water level (feet) 80' below top of ground.
- (4) casing PVC, 145' (material) (depth)  
4" (size) if telescope see back.
- (5) screen 10' 145' (length) (depth to top)  
0.13, PVC (size) (material)
- (6) pump 1/2 10 (HP) (yield gpm)  
220 V (type power)
- (7) electric log NO (yes or no)  
(organization running log)
- (8) how well bottom plugged Cap

description of formations encountered


from to

Red clay 0 10

Gravel & Red sand 10 30

Black clay 30 90

White sand 90 155

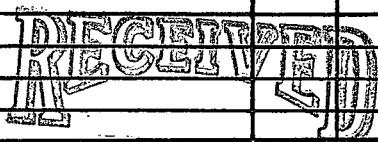


NOV - 1 1985

DRILLERS REMARKS:

If well telescopes please sketch and show depths.

GROUND LEVEL

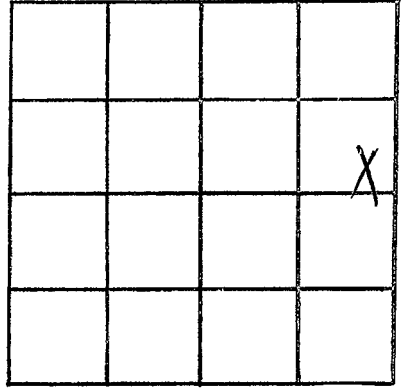

SECTION 12

Please indicate well location X.

ADDITIONAL INFORMATION

If more than one screen,  
show locations of each on sketch.