

MISSISSIPPI DEPARTMENT OF NATURAL RESOURCES

Bureau of Land and Water Resources

Southport Mall

P.O. Box 10631

Jackson, Mississippi 39209

WATER WELL DRILLERS LOG

HICKS WELL COMPANY

TATE
M 2005

8-12 1985 RT. 1 - BOX 157 TATE
date well completed firm name county well located

LANDOWNER: Dewhitt Hawkins
Rt # 2 Box 264
Coldwater MS 38618
(mailing address)

description of formations encountered	from	to
Red Clay	0	10
Red Sand	10	20
Gravel	20	60
Black Clay	60	100
White Sand	100	130

WELL LOCATION:
sec. 4 T 6 N R 7 E
S W
3 miles SE of Senatobia
(distance) (direction) (nearest town)

WELL PURPOSE: Home
(home, irrigation, municipal, industrial)

WELL COMPLETION DATA:

(1) diameter (inches) 4"

(2) total depth (feet) 130'

(3) static water level (feet) 80' below above top of ground.

(4) casing PVC 120' (material) (depth)
4" (size) if telescope see back.


(5) screen 10' 120' (length) (depth to top)
0.13" PVC (size) (material)

(6) pump 3/4 10 (HP) (yield gpm)
220 V (type power)

(7) electric log NO (yes or no)
(organization running log)

(8) how well bottom plugged Cap


DRILLERS REMARKS:

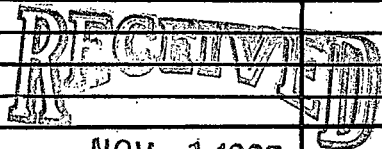

NOV - 1 1985

If well telescopes please sketch and show depths.

GROUND LEVEL

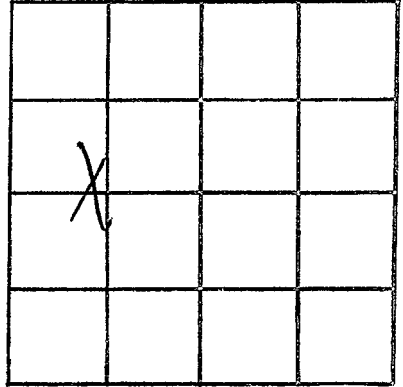

SECTION 4

Please indicate well location X.

ADDITIONAL INFORMATION

If more than one screen, show locations of each on sketch.