

**MISSISSIPPI DEPARTMENT OF NATURAL RESOURCES**  
Bureau of Land and Water Resources

P.O. Box 10631  
Jackson, Mississippi 39209  
**WATER WELL DRILLERS LOG**

COUNTY WELL LOCATED <i>Jate</i>	
WELL NUMBER <i>M</i>	CODED
DATE WELL COMPLETED <i>3-20-88</i>	

PERMIT NUMBER
NAME OF DRILLING FIRM <i>HICKS WELL COMPANY</i>
RT. 1 BOX 157 <i>SENATOBIA, MISS.</i>

NAME & MAILING ADDRESS OF LANDOWNER <i>Climmie Jones</i> <i>Re # 3</i> <i>Senatobia, MS 38668</i>		
WELL LOCATION: SEC	TOWNSHIP	RANGE
<i>5</i>	<i>6</i>	<i>7</i>
DISTANCE	DIRECTION	NEAREST TOWN
<i>3</i> Miles	<i>SE</i> of	<i>Senatobia</i>
OTHER LANDMARK		
WELL PURPOSE: <input checked="" type="checkbox"/> Irrigation, <input type="checkbox"/> Municipal, <input type="checkbox"/> Industrial, <input type="checkbox"/> Fish Pond, etc.		


<b>PUMP DATA</b>		
PUMP TYPE (Circle One): <input checked="" type="checkbox"/> Submersible, <input type="checkbox"/> Turbine, <input type="checkbox"/> Jet <input type="checkbox"/> Flowing Well, Other (Describe) _____		
POWER TYPE (Circle One): <input checked="" type="checkbox"/> Electric, <input type="checkbox"/> Tractor, <input type="checkbox"/> Diesel, <input type="checkbox"/> Gasoline, <input type="checkbox"/> Butane, Other (Describe) _____		
Pump Capacity (GPM)	No. of Stages	Setting Depth
<i>10</i>	<i>7</i>	<i>40</i> FT.
PUMP TEST		
Well yielded _____ GPM with a drawdown of _____ ft. after _____ hours of pumping		

<b>WELL DATA</b>		
Well Depth <i>95'</i>	Casing Diameter (in.) <i>4"</i>	Casing Length (Ft.) <i>85'</i>
Type of Casing <i>Pvc</i>	Hole Depth <i>95'</i>	Depth to Static Water Level <i>20'</i>
TYPE OF COMPLETION: (Circle One or More): Gravel Packed, <input type="checkbox"/> Underreamed, <input type="checkbox"/> Telescoped, Natural Development, <input type="checkbox"/> Open Hole, <input type="checkbox"/> Other (Describe) <i>Pvc cap</i>		
Top of Lap Pipe or Reduction in Casing  FEET <input type="checkbox"/> IF TELESCOPED OR MORE THAN ONE SCREEN: USE BACK PAGE		

<b>LOG DATA</b>	
TYPE OF LOG RUN (Circle One): <input type="checkbox"/> No Log Run, <input type="checkbox"/> Electric, <input type="checkbox"/> Gamma Ray, <input type="checkbox"/> Density, <input type="checkbox"/> Sonic, <input type="checkbox"/> Neutron, Other (Describe) _____	
Name of Organization Running Log	

<b>SCREEN DATA</b>		
Diameter - Inches <i>4"</i>	Length - Feet <i>10'</i>	Slot Size - Inches <i>013</i>
Screen Type <i>Pvc</i>	Depth to Bottom - Feet <i>95'</i>	


<b>GEOLOGIC DATA (Office Use Only)</b>			
Surface Elev.	Geologic Unit	Unit Thickness	Depth to Top
Subs. SWL	Date	Analysis	Aquifer Test
Driller's Remarks			

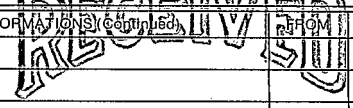DESCRIPTION OF FORMATIONS ENCOUNTERED	FROM	TO	FORMATIONS (continued)	FROM	TO
<i>Red clay</i>	<i>0</i>	<i>15</i>	 <b>APR 27 1988</b> Department of Natural Resources Bureau of Land & Water Resources		
<i>Sand</i>	<i>15</i>	<i>60</i>			
<i>White sand</i>	<i>60</i>	<i>95</i>			

IF MORE SPACE IS NEEDED, USE BACK

If well telescopes please  
sketch and show depths.

GROUND LEVEL

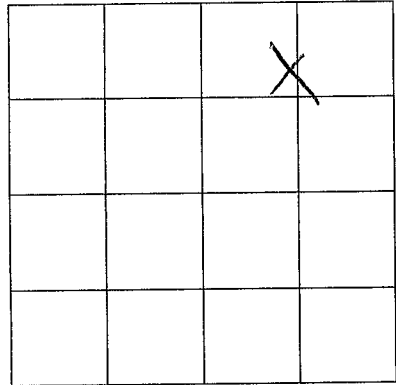

SECTION 5

Please indicate well location X.

ADDITIONAL INFORMATION

If more than one screen,  
show location of each on sketch.