

MISSISSIPPI DEPARTMENT OF NATURAL RESOURCES

Bureau of Land and Water Resources

P.O. Box 10631

Jackson, Mississippi 39209

WATER WELL DRILLERS LOG

COUNTY WELL LOCATED TATE	
WELL NUMBER M	CODED
DATE WELL COMPLETED 203489	
12-6-89	

PERMIT NUMBER
HICKS WELL CO.
RT. 1 BOX 157
SENATOBIA, MS 38668

NAME & MAILING ADDRESS OF LANDOWNER Robert T Murphey			
RT. 1			
Senatobia, MS			
WELL LOCATION:	SEC	TOWNSHIP	RANGE
	27	6	N 7 E
DISTANCE	DIRECTION	NEAREST TOWN	
2 Miles	NE	of Senatobia	
OTHER LANDMARK			
WELL PURPOSE: Home, Irrigation, Municipal, Industrial, Fish Pond, etc.			

PUMP DATA			
PUMP TYPE (Circle One): <u>Submersible</u> , Turbine, Jet, Flowing Well, Other (Describe) _____			
POWER TYPE (Circle One): <u>Electric</u> , Tractor, Diesel, Gasoline, Butane, Other (Describe) _____ H/P <u>1/2</u>			
Pump Capacity (GPM)	No. of Stages	Setting Depth	
10	9	80 FT.	
PUMP TEST			
Well yielded _____ GPM with			
a drawdown of _____ ft.			
after _____ hours of pumping			

WELL DATA		
Well Depth 130	Casing Diameter (In.) 4"	Casing Length (Ft.) 120
Type of Casing PVC	Hole Depth 130	Depth to Static Water Level 60
TYPE OF COMPLETION: (Circle One or More): <u>Gravel Packed</u> , Underreamed, Telescoped, Natural Development, Open Hole, Other		
Top of Lap Pipe or Reduction in Casing		
FEET IF TELESCOPED OR MORE THAN ONE SCREEN: USE BACK PAGE		

LOG DATA	
TYPE OF LOG RUN (Circle One): No Log Run, Electric, Gamma Ray, Density, Sonic, Neutron, Other (Describe) _____	
Name of Organization Running Log	


SCREEN DATA		
Diameter - Inches 4"	Length - Feet 10'	Slot Size - Inches 013
Screen Type PVC	Depth to Bottom - Feet 10	

GEOLOGIC DATA (Office Use Only)			
Surface Elev.	Geologic Unit	Unit Thickness	Depth to Top
Subs. SWL	Date	Analysis	Aquifer Test
Driller's Remarks			

DESCRIPTION OF FORMATIONS ENCOUNTERED	FROM	TO	FORMATION(S) (Continued) FROM	TO
RC	0	20		
RCWS	20	60		
WCWS	60	85		
WS	85	130		
<div style="border: 1px solid black; padding: 5px; display: inline-block;"> RECEIVED DEC 11 1989 </div>				
Department of Natural Resources Bureau of Land & Water Resources				
IF MORE SPACE IS NEEDED, USE BACK				

If well telescopes please sketch and show depths.

GROUND LEVEL

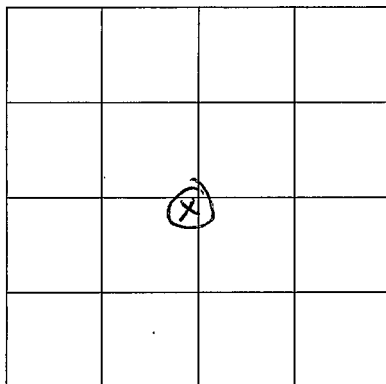

SECTION _____

Please indicate well location X.

ADDITIONAL INFORMATION

If more than one screen,
show location of each on sketch.