

MISSISSIPPI DEPARTMENT OF NATURAL RESOURCES

Bureau of Land and Water Resources

COUNTY WELL LOCATED TATE	
WELL NUMBER M	CODED
DATE WELL COMPLETED 8-16-90	

PERMIT NUMBER HICKS WELL CO.
NAME OF DRILLING FIRM RT. 1 BOX 157 SENATOBIA, MS 38668

P.O. Box 10631
Jackson, Mississippi 39209
WATER WELL DRILLERS LOG

NAME & MAILING ADDRESS OF LANDOWNER John Champion Senatobia, MS 38668		
WELL LOCATION: SEC	TOWNSHIP	RANGE
S	6	N 7 W
DISTANCE	DIRECTION	NEAREST TOWN
2 Miles	S	of Senatobia
OTHER LANDMARK		
WELL PURPOSE: <input checked="" type="checkbox"/> Home Irrigation, <input type="checkbox"/> Municipal, <input type="checkbox"/> Industrial, <input type="checkbox"/> Fish Pond, etc.		

PUMP DATA		
PUMP TYPE (Circle One): <input checked="" type="radio"/> Submersible Turbine Jet Flowing Well, Other (Describe) _____		
POWER TYPE (Circle One): <input checked="" type="radio"/> Electric Tractor, Diesel, Gasoline, Butane, Other (Describe) _____ H/P <input checked="" type="checkbox"/>		
Pump Capacity (GPM) 18	No. of Stages 12	Setting Depth 100 FT.
PUMP TEST Well yielded 18 GPM with a drawdown of _____ ft. after _____ hours of pumping		

WELL DATA		
Well Depth 160	Casing Diameter (In.) 4"	Casing Length (Ft.) 150
Type of Casing PVC	Hole Depth 160	Depth to Static Water Level 100
TYPE OF COMPLETION: (Circle One or More): <input checked="" type="checkbox"/> Gravel Packed, <input type="checkbox"/> Underreamed, <input type="checkbox"/> Telescoped, <input type="checkbox"/> Natural Development, <input type="checkbox"/> Open Hole, <input type="checkbox"/> Other (Describe) _____		
Top of Lap Pipe or Reduction in Casing FEET IF TELESCOPED OR MORE THAN ONE SCREEN: USE BACK PAGE		

LOG DATA	
TYPE OF LOG RUN (Circle One): No Log Run, Electric, Gamma Ray, Density, Sonic, Neutron, Other (Describe) _____	
Name of Organization Running Log	

SCREEN DATA		
Diameter - Inches 4"	Length - Feet 10'	Slot Size - Inches 0.13
Screen Type PVC	Depth to Bottom - Feet 10'	

GEOLOGIC DATA (Office Use Only)			
Surface Elev.	Geologic Unit	Unit Thickness	Depth to Top
Subs. SWL	Date	Analysis	Aquifer Test
Driller's Remarks			


DESCRIPTION OF FORMATIONS ENCOUNTERED	FROM	TO
RC	0	10
RC & S	10	60
WC & S	60	110
WS	110	160

FORMATIONS (Continued)	FROM	TO
<div style="border: 2px solid black; padding: 5px; font-weight: bold; font-size: 1.5em;">RECEIVED</div> <p style="text-align: center; font-weight: bold; font-size: 1.2em;">AUG 28 1990</p> <p style="text-align: center; font-weight: bold; font-size: 0.8em;">Department of Natural Resources Bureau of Land & Water Resources</p>		

IF MORE SPACE IS NEEDED, USE BACK

If well telescopes please
sketch and show depths.

GROUND LEVEL

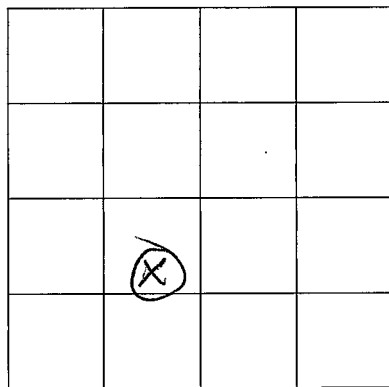

SECTION _____

Please indicate well location X.

ADDITIONAL INFORMATION

If more than one screen,
show location of each on sketch.