

MISSISSIPPI DEPARTMENT OF ENVIRONMENTAL QUALITY

Office of Land and Water Resources

COUNTY WELL LOCATED <i>Itate</i>
WELL NUMBER <i>M</i>
DATE WELL COMPLETED <i>2048 11-9-94</i>

PERMIT NUMBER
HICKS WELL CO.

NAME OF DRILLING COMPANY
**RT. 1 BOX 157
SENATOBIA, MS 38668**

P. O. Box 10631
Jackson, MS 39289-0631
WATER WELL DRILLERS LOG

NAME & MAILING ADDRESS OF LANDOWNER
Deborah DeWitt

Elisabeth Walleys
Senatobia MS

WELL LOCATION.	SEC	TOWNSHIP	RANGE
	<i>18</i>	<i>6 N</i>	<i>7 E</i>

DISTANCE *4* Miles DIRECTION *South* of NEAREST TOWN *Senatobia*

OTHER LANDMARK

WELL PURPOSE (Home Irrigation, Municipal, Industrial, Fish Pond, etc.)

PUMP DATA

PUMP TYPE (Circle One):
Submersible Turbine, Jet, Flowing Well,
Other (Describe)

POWER TYPE (Circle One):
Electric, Tractor, Diesel, Gasoline, Butane,
Other (Describe) *H/P 1/2*

Pump Capacity (GPM)	No. of Stages	Setting Depth
<i>10</i>		<i>100 FT.</i>

PUMP TEST

Well yielded _____ GPM with
a drawdown of _____ ft.
after _____ hours of pumping

WELL DATA

Well Depth	Casing Diameter (In.)	Casing Length (Ft.)
<i>135'</i>	<i>4"</i>	<i>125'</i>

Type of Casing	Hole Depth	Depth to Static Water Level
<i>Pvc</i>	<i>135'</i>	<i>80'</i>

TYPE OF COMPLETION: (Circle One or More):
Gravel Packed, Underreamed, Telescoped,
Natural Development, Open Hole, Other

WELL GROUTED TO A DEPTH OF 3 FEET
Type Grout (circle one): Cement, Bentonite, or Mix

LOG DATA

TYPE OF LOG RUN (Circle One):
No Log Run, Electric, Gamma Ray, Density, Sonic, Neutron,
Other (Describe)

Name of Organization Running Log

SCREEN DATA

Diameter - Inches	Length - Feet	Slot Size - Inches
<i>4"</i>	<i>10'</i>	<i>.013</i>

Screen Type	Depth to Bottom - Feet
<i>Pvc</i>	<i>135</i>

GEOLOGIC DATA (Office Use Only)

Surface Elev.	Geologic Unit	Unit Thickness	Depth to Top
Subs. SWL	Date	Analysis	Aquifer Test

Driller's Remarks

Top of Lap Pipe or Reduction in Casing

FEET IF TELESCOPED OR MORE THAN ONE SCREEN: USE BACK PAGE

DESCRIPTION OF FORMATIONS ENCOUNTERED	FROM	TO
<i>Red Sand</i>	<i>0</i>	<i>60</i>
<i>Sand & Clay</i>	<i>60</i>	<i>100</i>
<i>white sand</i>	<i>120</i>	<i>135</i>

FORMATIONS (Continued)

FROM	TO

RECEIVED


MAR 13 1995

Dept. of Environmental Quality
Office of Land & Water Resources

IF MORE SPACE IS NEEDED, USE BACK

If well telescopes please sketch and show depths.

GROUND LEVEL

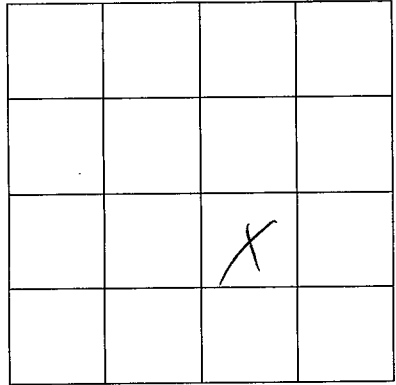

SECTION 18

Please indicate well location X.

ADDITIONAL INFORMATION

If more than one screen,
show location of each on sketch.