

TATE
 N 2
 12-28-70

MISSISSIPPI
 BOARD OF WATER COMMISSIONERS
 416 North State Street
 Jackson, Mississippi 39201

CODED

WATER WELL DRILLERS LOG

12-28 1970 Harris Bros. Tate
 date well completed firm name county well located

LANDOWNER: George Soreberry
 pt. 1
 Senatobia
 (mailing address)

description of formations encountered	from	to
top soil	0	20
red sand	20	45
white clay	45	75
clay + sand	75	130
course sand	130	140

WELL LOCATION:
 sec. 16 T. 6 N R. 6 E
 2 1/2 miles S of Longphome
 (distance) (direction) (nearest town)

WELL PURPOSE: none
 (home, irrigation, municipal, industrial)

- WELL COMPLETION DATA:
- (1) diameter (inches) 4
 - (2) total depth (feet) 140
 - (3) static water level (feet) 80 ^{below} top of ground.
 - (4) casing Plastic, 133' (material) (depth)
 - 4" if telescope see back. (size)
 - (5) screen 7' 133' (length) (depth to top)
 - 008, Plastic (size) (material)
 - (6) pump 3/4 7 (HP) (yield gpm)
 - elec. (type power)
 - (7) electric log no (yes or no)

CODED

(organization running log)

(8) how well bottom plugged much
shot


MAY 14 1971

MISSISSIPPI
 BOARD OF WATER COMMISSIONERS
 JACKSON, MISSISSIPPI

DRILLERS REMARKS:

If well telescopes please sketch and show depths.

GROUND LEVEL

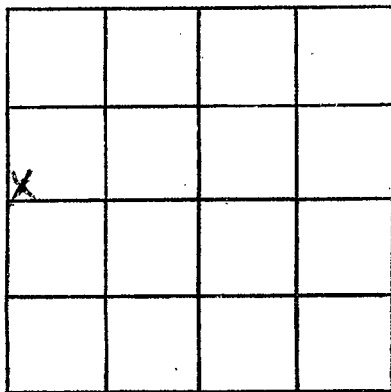

SECTION 16

Please indicate well location X.

ADDITIONAL INFORMATION

If more than one screen,
show locations of each on sketch.