

Tate
N3
11-29-91

MISSISSIPPI
BOARD OF WATER COMMISSIONERS
416 North State Street
Jackson, Mississippi 39201

DEC 8 1971

CODED

WATER WELL DRILLERS LOG

11-29 1971 date well completed
Harris Bros. firm name
Tate county well located

LANDOWNER: J. W. Holden Jr.
Pt. 1
Senobia
(mailing address)

description of formations encountered	from	to
top soil	0	20
red sand	20	65
clay + sand	65	110
Coarse sand	110	120

WELL LOCATION:
sec. 5 T. 6 N R. 6 E
1 miles S of Osborn
(distance) (direction) (nearest town)

WELL PURPOSE: none
(home, irrigation, municipal, industrial)


WELL COMPLETION DATA:
(1) diameter (inches) 4
(2) total depth (feet) 120
(3) static water level (feet) 60 below above top of ground.
(4) casing Plastic 113
(material) (depth)
4 (size) if telescope see back.
(5) screen 7 113
(length) (depth to top)
008 Plastic
(size) (material)
(6) pump 3/4 7
(HP) (yield gpm)
elec.
(type power)
(7) electric log no
(yes or no)
(organization running log)
(8) how well bottom plugged back
sand

CODED

DRILLERS REMARKS:

If well telescopes please sketch and show depths.

GROUND LEVEL

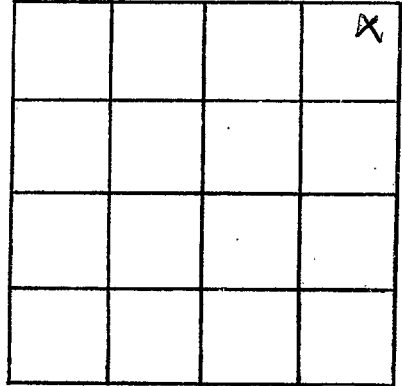

SECTION 5

Please indicate well location X.

ADDITIONAL INFORMATION

If more than one screen, show locations of each on sketch.