

Date
 N 5
 10-25-68

MISSISSIPPI
 BOARD OF WATER COMMISSIONERS
 416 North State Street
 Jackson, Mississippi 39201

CODED

WATER WELL DRILLERS LOG

10-25, 1968 date well completed
 Shelby Neyman firm name
 Tate county well located

LANDOWNER: James Archie
 R. F. D. 1
 Senatobia, Miss
 (mailing address)

description of formations encountered	from	to
Red clay	0	18
Red sand & gravel	18	100
white sand	100	115

WELL LOCATION:
 sec. 7 T. 6 N. R. 6 E
 S W
 7 miles East of Senatobia
 (distance) (direction) (nearest town)

CODED

WELL PURPOSE: Home
 (home, irrigation, municipal, industrial)

- WELL COMPLETION DATA:
- (1) diameter (inches) 7
 - (2) total depth (feet) 112
 - (3) static water level (feet) 38 below top of ground.
 - (4) casing Galvne / 105
 (material) (depth)
 (size) If telescope see back.
 - (5) screen 6 ft
 (length) (depth to top)
1 1/2 gauge
 (size) (material)
 - (6) pump 1 / 12
 (HP) (yield gpm)
Electric
 (type power)
 - (7) electric log no
 (yes or no)
no
 (organization running log)
 - (8) how well bottom plugged Butter Seal


NOV 12 1968

MISS. BD. OF
 WATER COMM.

DRILLERS REMARKS:

If well telescopes please sketch and show depths.

GROUND LEVEL

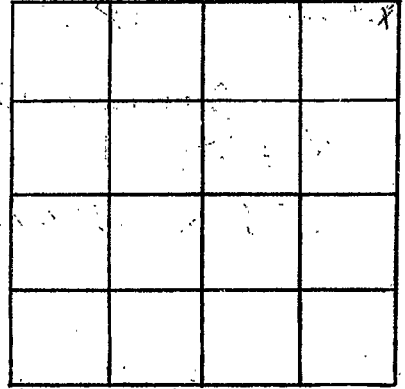

SECTION 7

Please indicate well location X.

ADDITIONAL INFORMATION

If more than one screen, show locations of each on sketch.