

TATE
 N 7
 4-15-69

MISSISSIPPI
 BOARD OF WATER COMMISSIONERS
 416 North State Street
 Jackson, Mississippi 39201

CODED

WATER WELL DRILLERS LOG

4-15 1969 Harvie Bros. Tate
 date well completed firm name county well located

LANDOWNER: Henry Roseman
Rt 1
Senatoria
 (mailing address)

description of formations encountered	from	to
top soil	0	15
gravel & sand	15	40
fine sand & clay	40	110
Coarse sand	110	127

WELL LOCATION:
 sec. 6 T. 6 N. R. 6 E
7 1/2 miles SE of Senatoria
 (distance) (direction) (nearest town)

WELL PURPOSE: none
 (home, irrigation, municipal, industrial)

WELL COMPLETION DATA:

(1) diameter (inches) 4"

(2) total depth (feet) 127

(3) static water level (feet) 80 below top of ground.
 above

(4) casing Plastic, 120
 (material) (depth)

4
 (size) If telescope see back.

(5) screen 7, 120
 (length) (depth to top)

008, Plastic
 (size) (material)

(6) pump 3/4, 7
 (HP) (yield gpm)

elec
 (type power)

(7) electric log no
 (yes or no)

(organization running log)


(8) how well bottom plugged much
shot

DRILLERS REMARKS:

DEC 22 1969
 MISS. PD - OR
 WATER CONTROL

If well telescopes please sketch and show depths.

GROUND LEVEL

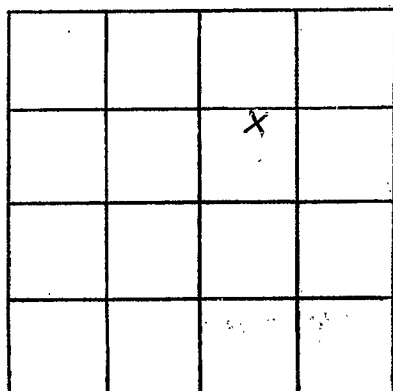

SECTION _____

Please indicate well location X.

ADDITIONAL INFORMATION

If more than one screen, show locations of each on sketch.