

Tate Co
 N 8
 2-10-70

MISSISSIPPI
 BOARD OF WATER COMMISSIONERS
 416 North State Street
 Jackson, Mississippi 39201

COPIED

WATER WELL DRILLERS LOG

2-10-70 date well completed 1970 Harris Bros firm name Tate county well located

LANDOWNER: Willie Partee
Rte. 1
Senatobia
 (mailing address)

description of formations encountered	from	to
top soil	0	15
white clay sand	15	90
white clay	80	115
course white sand	115	130

WELL LOCATION:
 sec. 16 T 6 N 5 R 6 E WP
3 miles S of Irish ham
 (distance) (direction) (nearest town)

WELL PURPOSE: home
 (home, irrigation, municipal, industrial)

- WELL COMPLETION DATA:
- (1) diameter (inches) 4"
 - (2) total depth (feet) 130
 - (3) static water level (feet) 80 below above top of ground.
 - (4) casing Plastic, 123,
 (material) (depth)
4 if telescope see back.
 (size)
 - (5) screen 7', 123
 (length) (depth to top)
008, Plastic
 (size) (material)
 - (6) pump 3/4, 7
 (HP) (yield gpm)
elec.
 (type power)
 - (7) electric log no
 (yes or no)

COPIED

(organization running log)
 (8) how well bottom plugged back
shot


DATE
 MAR 25 1970

DRILLERS REMARKS:

MISS. DE. OF
 WATER

If well telescopes please sketch and show depths.

GROUND LEVEL

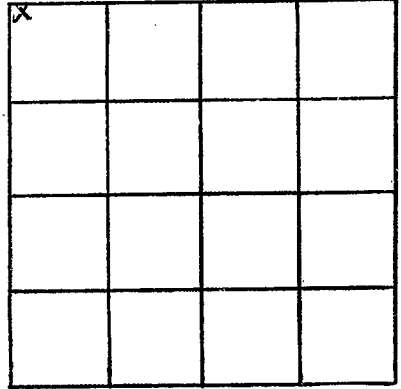

SECTION 16

Please indicate well location X.

ADDITIONAL INFORMATION

If more than one screen,
show locations of each on sketch.