

TATE
N 10
5-26-72

MISSISSIPPI
BOARD OF WATER COMMISSIONERS
416 North State Street
Jackson, Mississippi 39201

CODED

WATER WELL DRILLERS LOG

5-26-1972 G. & H. Well Co. TATE
date well completed firm name county well located

LANDOWNER: M. P. Moore
Senatobia Miss.
(mailing address)

description of formations encountered	from	to
Red SAND clay	0	15
Red SAND	15	45
SANDY Gravel	45	120
WHITE SAND	120	140

WELL LOCATION:
sec. 8 T 6 N R 6 E
7 miles S-E of Senatobia
(distance) (direction) (nearest town)

WELL PURPOSE: Home & FARM
(home, irrigation, municipal, industrial)

- WELL COMPLETION DATA:
- (1) diameter (inches) 4"
 - (2) total depth (feet) 140'
 - (3) static water level (feet) 83' ^Xbelow above top of ground.
 - (4) casing PLASTIC, 135' (material) (depth)
(size) if telescope see back.
 - (5) screen 5' 5' (length) (depth to top)
1/2" Gravel (size) (material)
 - (6) pump 1 20 (HP) (yield gpm)
220 Fier (type power)
 - (7) electric log NO (yes or no)
(organization running log)
 - (8) how well bottom plugged CAP

CODED


JUN 14 1972

MISS. BD. OF
WATER COMM.

DRILLERS REMARKS:

If well telescopes please sketch and show depths.

GROUND LEVEL

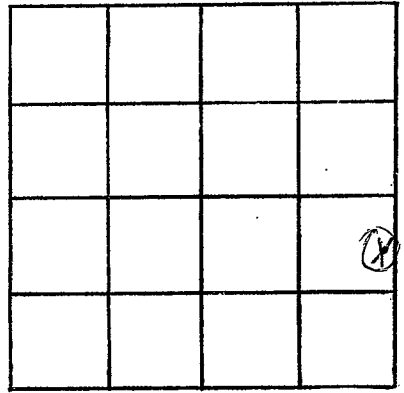

SECTION _____

Please indicate well location X.

ADDITIONAL INFORMATION

A series of horizontal lines for writing additional information.

If more than one screen, show locations of each on sketch.