

TATE
N 11
11-15-71

MISSISSIPPI
BOARD OF WATER COMMISSIONERS
416 North State Street
Jackson, Mississippi 39201

CODED

WATER WELL DRILLERS LOG

11-15 1971 Harris Bros. Tate
date well completed firm name county well located

LANDOWNER: John W. Holdengr
pt. 1
Senatobia
(mailing address)

WELL LOCATION:
sec. 5 T 6 N R 6 E
1 1/2 miles SW of Lumberton
(distance) (direction) (nearest town)

WELL PURPOSE: home
(home, irrigation, municipal, industrial)

- WELL COMPLETION DATA:
- (1) diameter (inches) 4
 - (2) total depth (feet) 130
 - (3) static water level (feet) 80 ^{below}/_{above} top of ground.
 - (4) casing Plastic 123
(material) (depth)
4" if telescope see back.
(size)
 - (5) screen 7' 123
(length) (depth to top)
008 Plastic
(size) (material)
 - (6) pump 3/4 7
(HP) (yield gpm)
elec.
(type power)
 - (7) electric log no
(yes or no)

(organization running log)


(8) how well bottom plugged solid

description of formations encountered	depth	
	from	to
top soil	0	20
white clay	20	45
clay & sand	45	110
Coarse sand	110	130
CODED		
AUG - 7 1972		
MISS. BD. OF WATER COMM.		

DRILLERS REMARKS:

If well telescopes please sketch and show depths.

GROUND LEVEL

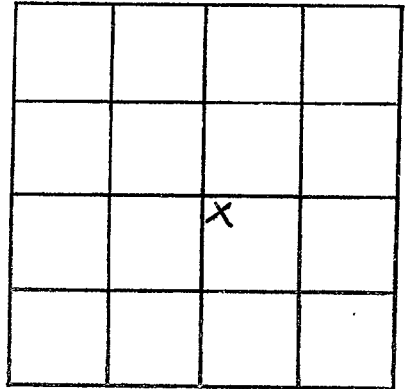

SECTION 5

Please indicate well location X.

ADDITIONAL INFORMATION

If more than one screen,
show locations of each on sketch.