

MISSISSIPPI  
BOARD OF WATER COMMISSIONERS  
416 North State Street  
Jackson, Mississippi 39201

WATER WELL DRILLERS LOG

**CODED**

TATE  
N 12  
9-9-72

9-9 1972 HICKS Brothers TATE  
date well completed firm name county well located

LANDOWNER: <u>Albert Freeman</u>	Description of formations encountered	from	to
<u>RT-1 SCANTOBIA MISS</u>	<u>Red CLAY</u>	<u>0</u>	<u>15</u>
	<u>Red SAND</u>	<u>15</u>	<u>75</u>
	<u>White SAND</u>	<u>75</u>	<u>150</u>

WELL LOCATION:  
sec. 10 T. 6 N. R. 6 E.  
7 1/2 miles EAST of SCANTOBIA  
(distance) (direction) (nearest town)

WELL PURPOSE: HOME  
(home, irrigation, municipal, industrial)

WELL COMPLETION DATA:

(1) diameter (inches) 4 1/2"

(2) total depth (feet) 150

(3) static water level (feet) 112 below above top of ground.

(4) casing PLASTIC, 1 1/4 (material), (depth) (size) if telescope see back.

(5) screen 6', 118' (length), (depth to top) (size), GRAVEL TYPE (material)

(6) pump 5/11, 10 (HP), (yield gpm)

220 ELEC (type power)

electric log (yes or no)

**CODED**


DRILLERS REM logged CAP

SEP 19 1972

MISS. BO. OF WATER COMMISSIONERS

If well telescopes please sketch and show depths.

GROUND LEVEL

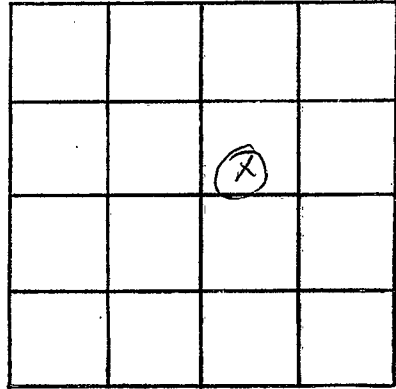

SECTION \_\_\_\_\_

Please indicate well location X.

ADDITIONAL INFORMATION

If more than one screen,  
show locations of each on sketch.