

TATE
N15
3-30-73

MISSISSIPPI
BOARD OF WATER COMMISSIONERS
416 North State Street
Jackson, Mississippi 39201

CODED

WATER WELL DRILLERS LOG

3-30 1973 Hinks Bro. Wells Tate
date well completed firm name county well located


LANDOWNER	description of formations encountered	from	to
John Dickerson Route 1 Senatobia, miss (mailing address)	Red clay Red SEA Sand White sand	0 15 30	15 30 40
WELL LOCATION:			
sec <u>5</u> T <u>6</u> N R <u>6</u> E (distance) miles <u>SE</u> of <u>S</u> (direction) (nearest town)			
WELL PURPOSE: <u>Home</u> (home, irrigation, municipal, industrial)			
WELL COMPLETION DATA:			
(1) diameter (inches) <u>4 in.</u>			
(2) total depth (feet) <u>140</u>			
(3) static water level (feet) <u>92</u> below above top of ground.			
(4) casing <u>Plastic, 140</u> (material) (depth)			
_____ if telescope see back. (size)			
(5) screen <u>5 ft</u> , <u>135</u> (length) (depth to top)			
<u>4 in.</u> , <u>Shavel</u> (size) (material)			
(6) pump <u>3/4</u> <u>10</u> (HP) (yield gpm)			
<u>Electric 220</u> (type power)			
(7) electric log <u>no</u> (yes or no)			
_____ (organization running log)			
(8) how well bottom plugged <u>Cap</u>			
DRILLERS REMARKS:			

CODED

APR 10 1973

If well telescopes please sketch and show depths.

GROUND LEVEL

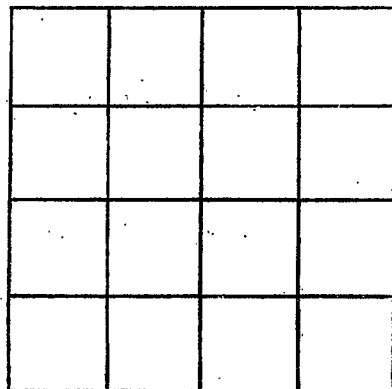

SECTION _____

Please indicate well location X.

ADDITIONAL INFORMATION

If more than one screen,
show locations of each on sketch.