

TATE
N 16
6-7-73

MISSISSIPPI
BOARD OF WATER COMMISSIONERS
416 North State Street
Jackson, Mississippi 39201

CODED

WATER WELL DRILLERS LOG

Jato

6-7-1973 date well completed Bob Smith firm name Jato county well located

LANDOWNER:
Verline Cozeland
Senatobia - Miss
(mailing address)

description of formations encountered	from	to
Clay dirt	70	8
white clay	8	25
Rock	at	25
sea gravel	26	40
white sand	40	135

WELL LOCATION:
sec. 7 T 6 N R 6 E
4 miles SE of New Town
(distance) (direction) (nearest town)

WELL PURPOSE: Home
(home, irrigation, municipal, industrial)

WELL COMPLETION DATA:

(1) diameter (inches) 4

(2) total depth (feet) 135

(3) static water level (feet) 100 below top of ground.

(4) casing Plastic 135
(material) (depth)

_____ if telescope see back.
(size)

(5) screen 30 115
(length) (depth to top)

4 Plastic
(size) (material)

(6) pump 1/2 10
(HP) (yield gpm)

E see
(type power)

(7) electric log 70
(yes or no)

_____ (organization running log)

(8) how well bottom plugged plugged


CODED

DRILLERS REMARKS:

SEP 27 1973

If well telescopes please sketch and show depths.

GROUND LEVEL

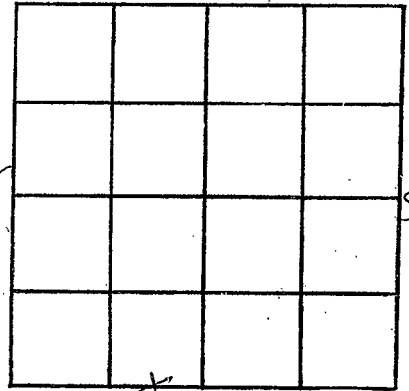

SECTION 7

Please indicate well location X.

ADDITIONAL INFORMATION

If more than one screen, show locations of each on sketch.