

TATE  
N17  
5-24-73

MISSISSIPPI  
BOARD OF WATER COMMISSIONERS  
416 North State Street  
Jackson, Mississippi 39201

(CODED)

WATER WELL DRILLERS LOG

5-24-1973 Bob Smith Jate  
date well completed firm name county well located

LANDOWNER:

Ken Maynor  
Snatobia - miss  
(mailing address)

description of formations encountered

	from	to
<u>Clay</u>	<u>90</u>	<u>7</u>
<u>gravel</u>	<u>7</u>	<u>15</u>
<u>white clay</u>	<u>15</u>	<u>40</u>
<u>blue clay</u>	<u>40</u>	<u>55</u>
<u>white sand</u>	<u>55</u>	<u>150</u>

WELL LOCATION:

sec. 6 T. 6 N. R. 6 E.  
3 1/2 miles SE of Mountaintop  
(distance) (direction) (nearest town)

WELL PURPOSE: None  
(home, irrigation, municipal, industrial)

WELL COMPLETION DATA:

- (1) diameter (inches) 4
- (2) total depth (feet) 150
- (3) static water level (feet) 60 below above top of ground.
- (4) casing Plastic 150  
(material) (depth)  
(size) If telescope see back.
- (5) screen 20 130  
(length) (depth to top)  
4 Plastic  
(size) (material)
- (6) pump 1/3 10  
(HP) (yield gpm)  
Elec.  
(type power)
- (7) electric log No  
(yes or no)  
(organization running log)
- (8) how well bottom plugged plugged


(CODED)

DRILLERS REMARKS:

SEP 27 1973

If well telescopes please sketch and show depths.

GROUND LEVEL

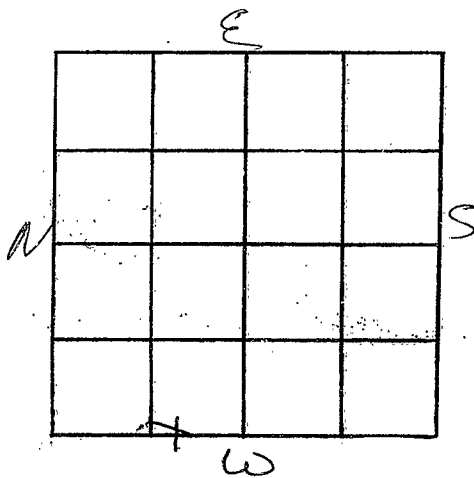

SECTION 6

Please indicate well location X.

**ADDITIONAL INFORMATION**

If more than one screen, show locations of each on sketch.