

TATE  
N 18  
6-20-13

MISSISSIPPI  
BOARD OF WATER COMMISSIONERS  
416 North State Street  
Jackson, Mississippi 39201

CODED

WATER WELL DRILLERS LOG

6-20 date well completed      23 Harris Bros. firm name      Tate county well located

LANDOWNER: William Mitchell  
211 Cherokee Drive  
Memphis, Tennessee  
(mailing address)

description of formations encountered	from	to
top soil	0	20
red sand	20	45
clay + fine sand	45	125
W. sand	125	150

WELL LOCATION:  
sec. 13 T. 6 N. R. 6 E.  
3 1/2 miles S of Bass  
(distance) (direction) (nearest town)

WELL PURPOSE: home  
(home, irrigation, municipal, industrial)

- WELL COMPLETION DATA:
- (1) diameter (inches) 4
  - (2) total depth (feet) 150
  - (3) static water level (feet) 80 <sup>below</sup> above top of ground.
  - (4) casing Plastic, 136  
(material) (depth)  
4 if telescope see back.  
(size)
  - (5) screen 14, 136  
(length) (depth to top)  
008, Plastic  
(size) (material)
  - (6) pump 3/4, 10  
(HP) (yield gpm)  
elec  
(type power)
  - (7) electric log No  
(yes or no)
  - (organization running log)
  - (8) how well bottom plugged solid

DRILLERS REMARKS:


CODED

DATE: 6-20-13

MISS. BU. I.  
JULY 1913

If well telescopes please sketch and show depths.

GROUND LEVEL

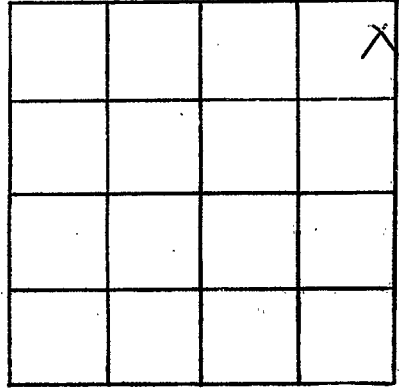

SECTION 13

Please indicate well location X.

ADDITIONAL INFORMATION

If more than one screen, show locations of each on sketch.