

TATE
N 19
4-15-74

MISSISSIPPI
BOARD OF WATER COMMISSIONERS
416 North State Street
Jackson, Mississippi 39201

CODED

WATER WELL DRILLERS LOG

4-15-74 date well completed
Blacks Bros. Well Co. firm name
Tate county well located

LANDOWNER:
Shurston Bullard
P.O. Box 251, Sumner
(mailing address) Miss

description of formations encountered	from	to
Red Clay	0	15
Red Sand	15	60
White Sand	60	120
White Sand & Clay	120	135
White Sand	135	175

WELL LOCATION:
sec. 16 T 6 N R 6 E
4 miles S of Sumner
(distance) (direction) (nearest town)

WELL PURPOSE: Stone
(home, irrigation, municipal, industrial)

WELL COMPLETION DATA:

(1) diameter (inches) 4 1/2
(2) total depth (feet) 175
(3) static water level (feet) 100 below top of ground.
(4) casing Plastic 125 (material) (depth)
(size) if telescope see back.
(5) screen 4 ft 171 (length) (depth to top)
4 in Gravel (size) (material)
(6) pump 1/2 8 (HP) (yield gpm)
Electric 110 (type power)
(7) electric log No (yes or no)
(organization running log)
(8) how well bottom plugged Cap

CODED


RECORDED
APR 25 1974

DRILLERS REMARKS:

MISS. BD. OF WATER COMMISSIONERS

If well telescopes please sketch and show depths.

GROUND LEVEL

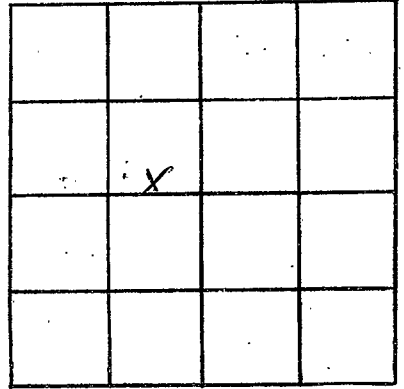

SECTION 16

Please indicate well location X.

ADDITIONAL INFORMATION

If more than one screen,
show locations of each on sketch.