

TATE  
N 20  
3-25-74

MISSISSIPPI  
BOARD OF WATER COMMISSIONERS  
416 North State Street  
Jackson, Mississippi 39201

WATER WELL DRILLERS LOG

3-25-74 Shibs Rouse Well Co. Late  
date well completed firm name county well located

LANDOWNER: Harold  
Wedges - Route 1  
Senatobia, Miss.  
(mailing address) 38668


description of fomations encountered	from	to
<u>Red Clay</u>	<u>0</u>	<u>15</u>
<u>Black Clay</u>	<u>15</u>	<u>30</u>
<u>Black Clay &amp; white Clay</u>	<u>30</u>	<u>60</u>
<u>white Clay</u>	<u>60</u>	<u>75</u>
<u>white Clay &amp; Sand</u>	<u>75</u>	<u>105</u>
<u>white Sand</u>	<u>105</u>	<u>120</u>
<u>white Clay &amp; Sand</u>	<u>120</u>	<u>150</u>
<u>white Sand</u>	<u>150</u>	<u>180</u>

WELL LOCATION:  
sec 2 T 6 N R 6 E  
3 miles SE of Senatobia  
(distance) (direction) (nearest town)

WELL PURPOSE: Home  
(home, irrigation, municipal, industrial)

WELL COMPLETION DATA:

- (1) diameter (inches) 4 1/2 in.
- (2) total depth (feet) 180 ft.
- (3) static water level (feet) 50 below above top of ground.
- (4) casing Plastic, 180  
(material) (depth)  
                     If telescope see back.  
(size)
- (5) screen 4 ft., 176  
(length) (depth to top)  
4 1/2 in., Gravel  
(size) (material)
- (6) pump 3/4 10  
(HP) (yield gpm)  
Electric 220  
(type power)
- (7) electric log no  
(yes or no)
- (organization running log)
- (8) how well bottom plugged Cap

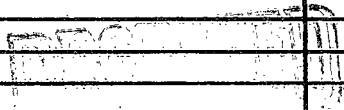

APR 25 1974

DRILLERS REMARKS:

MISSISSIPPI BOARD OF WATER COMMISSIONERS

