

TATE
N22
8-12-74

MISSISSIPPI
BOARD OF WATER COMMISSIONERS
416 North State Street
Jackson, Mississippi 39201

CODED

WATER WELL DRILLERS LOG

8-12 date well completed 1974 Bob Smith & Son firm name Tate county well located


| LANDOWNER: | description of formations encountered | from | to |
|--|---------------------------------------|------|------|
| Joseph Bell Senatobia, Miss. (mailing address) | | | |
| WELL LOCATION: | Gravel and clay | 12' | 30' |
| sec. 18 T. 6 N. R. 6 E 6 miles S of New Town (distance) (direction) (nearest town) | Red sand | 30' | 45' |
| WELL PURPOSE: Home (home, irrigation, municipal, industrial) | White sand | 45' | 171' |
| WELL COMPLETION DATA: | | | |
| (1) diameter (inches) 4" | | | |
| (2) total depth (feet) 171' | | | |
| (3) static water level (feet) 90 below top of ground. | | | |
| (4) casing Plastic, 171' (material) (depth) | | | |
| (size) If telescope see back. | | | |
| (5) screen 10' length, 161' depth to top | | | |
| 4" Plastic (size) (material) | | | |
| (6) pump 1/2 HP, 10 (yield gpm) | | | |
| electric (type power) | | | |
| (7) electric log NO (yes or no) | | | |
| (organization running log) | | | |
| (8) how well bottom plugged plugged | | | |
| DRILLERS REMARKS: | | | |

CODED

RECEIVED
AUG 25 1974

If well telescopes please sketch and show depths.

GROUND LEVEL

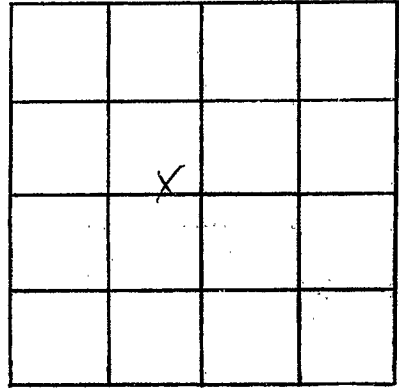

SECTION 18

Please indicate well location X.

ADDITIONAL INFORMATION

If more than one screen, show locations of each on sketch.