

TATE  
N24  
3-4-74

MISSISSIPPI  
BOARD OF WATER COMMISSIONERS  
416 North State Street  
Jackson, Mississippi 39201

WATER WELL DRILLERS LOG CODED

3-4 date well completed 1974 Harris Bros. firm name Tate county well located

LANDOWNER: W.C. Wallace  
Rt 1  
Senatobia  
(mailing address)

description of formations encountered	from	to
top soil	0	20
sand & peagranul	20	35
clay & sand	35	130
coarse sand	130	140

WELL LOCATION:  
sec. 5 T. 6 N. R. 6 E  
1 1/2 miles SW of Soso, Tenn.  
(distance) (direction) (nearest town)

WELL PURPOSE: home  
(home, irrigation, municipal, industrial)

WELL COMPLETION DATA:

(1) diameter (inches) 4

(2) total depth (feet) 140

(3) static water level (feet) 80 <sup>below</sup>/<sub>above</sub> top of ground.

(4) casing Plastic, 133,  
(material) (depth)  
4 (size) if telescope see back.

(5) screen 7, 133  
(length) (depth to top)  
1/8", Plastic,  
(size) (material)

(6) pump 3/4, 10  
(HP) (yield gpm)  
elec.  
(type power)

(7) electric log NO  
(yes or no)

(organization running log)

(8) how well bottom plugged solid


CODED

RECEIVED  
OCT 11 1974

DRILLERS REMARKS:

If well telescopes please sketch and show depths.

GROUND LEVEL

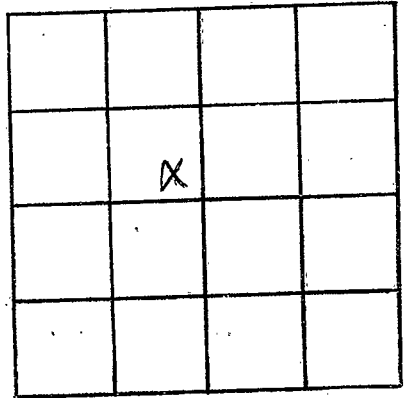

SECTION 5

Please indicate well location X.

ADDITIONAL INFORMATION

If more than one screen, show locations of each on sketch.