

TATE
N 25
10/9/74

MISSISSIPPI
BOARD OF WATER COMMISSIONERS
416 North State Street
Jackson, Mississippi 39201

CODED

WATER WELL DRILLERS LOG

OCT 9
date well completed

1974 WATSON Co.
firm name

TATE
county well located

LANDOWNER: MIKE MASSEY	description of formations encountered		from	to
SENATORIA, MISS.	SURFACE CLAY		0	12
(mailing address)	SAND & GRAVEL		12	17
WELL LOCATION:	SAND		17	32
sec. 11 T 6 N R 6 E	WHITE CLAY		32	75
4 miles SE of SENATORIA	SAND		75	117
(distance) (direction) (nearest town)				
WELL PURPOSE: HOME				
(home, irrigation, municipal, industrial)				
WELL COMPLETION DATA:				
(1) diameter (inches) 4"	CODED			
(2) total depth (feet) 117'				
(3) static water level (feet) 70' below top of ground.				
(4) casing PVC, 107' (material) (depth)				
(size) if telescope see back.				
(5) screen 10', 107' (length) (depth to top)				
4", PVC (size) (material)				
(6) pump 1/2 HP, 12 GPM (HP) (yield gpm)				
ELEC (type power)				
(7) electric log No (yes or no)				
(organization running log)				
(8) how well bottom plugged PVC PLUG				
DRILLERS REMARKS:				


DRILLERS REMARKS

OCT 24 1974

MISSISSIPPI BOARD OF WATER COMMISSIONERS

If well telescopes please sketch and show depths.

GROUND LEVEL

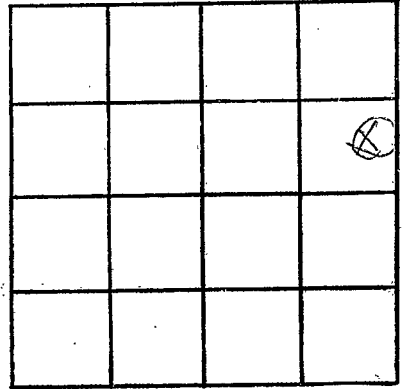

SECTION 11

Please indicate well location X.

ADDITIONAL INFORMATION

If more than one screen, show locations of each on sketch.