

TATE  
N 29  
10/21/74

MISSISSIPPI  
BOARD OF WATER COMMISSIONERS  
416 North State Street  
Jackson, Mississippi 39201  
WATER WELL DRILLERS LOG

CODED

10-21-1974 date well completed  
V. Links Exp. Well Co. firm name  
Tate county well located

LANDOWNER: Charles  
Mc Clendon - Rt 1  
Senatobia, Miss.  
(mailing address) 33662

description of formations encountered	from	to
red clay	0	15
Gravel	15	30
white sand & gravel	30	45
Black Clay	45	90
black clay + white sand	90	105
white sand	105	124

WELL LOCATION:  
sec. 7 T 6 N R 6 E  
S miles SE of New Town  
(distance) (direction) (nearest town)

WELL PURPOSE: domestic  
(home, irrigation, municipal, industrial)


- WELL COMPLETION DATA:
- diameter (inches) 4 in.
  - total depth (feet) 124
  - static water level (feet) 45 below top of ground.
  - casing Plastic, 124 (material) (depth)
  - screen 4 in., 120 (length) (depth to top)  
4 in., Gravel (size) (material)
  - pump 1/2 (HP) 10 (yield gpm)  
Electric 230 (type power)
  - electric log No (yes or no)
  - organization running log
  - how well bottom plugged Cap

RECORDED  
INDEXED  
DEC - 2 1974

DRILLERS REMARKS:

If well telescopes please sketch and show depths.

GROUND LEVEL

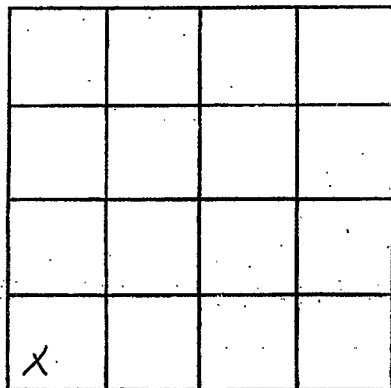

SECTION 2

Please indicate well location X.

ADDITIONAL INFORMATION

If more than one screen, show locations of each on sketch.