

State Well Report

Part 1 - Driller's Log

Mississippi Department of Environmental Quality
Office of Land and Water Resources
P.O. Box 10631
Jackson, MS 39289-0631
(601)961-5210
(601)354-6938 (fax)

County: ITTE
Permit #: _____
Driller: ELMER FORK
Date drilling completed: 6-15-07

For Office Use Only:
Aquifer: _____
Well #: N-55
L. S. Elevation: _____
E-log #: _____

State Law requires that this report be prepared by the license holder responsible for the work and filed with the Department at the above address within 30 days of completion of drilling of the well or borehole.

Information on Well Owner (Landowner if borehole is not for a water well)	Well or Borehole Location
Owner Name: <u>DON SMITH</u>	Latitude: _____ Longitude: _____
Mailing Address: <u>403 LEWIS CHAPEL</u>	Method of Lat/Long (circle one): Conventional Survey, USGS quad, Hand-held GPS, Survey-grade GPS
<u>SELATOBIA MS</u> City State Zip Code	_____ 1/4 _____ 1/4 Sec <u>2</u> Twn <u>6 S</u> Rng <u>6 W</u>
Telephone No. () _____	Distance Direction Nearest Town <u>3</u> Miles <u>SW</u> of <u>LAOXA HAMM</u>

Well / Borehole Data

Date drilling started: 6-15 Date drilling completed: 6-15 Hole depth: 180 Hole diameter: 6 7/8"

Location of the source of any surface water used for drilling: DOME WELL

Method of dosing and volume of Chlorine used in drilling and development: 2 GAL CHLORAX

Logs run (circle all applicable): No log run Electric Gamma Ray Density Sonic Neutron Other: _____

Name of organization running log(s): _____
(Attach copy of log to this report)

Purpose of borehole (check one): Water Well Geotechnical/Geological Investigation _____ Ground Source Heat Pump _____
Seismic Survey _____ Other (describe) _____

If drilling is not related to water well construction, skip the remainder of this block

Purpose of Well (check one): Home Industrial _____ Public Supply _____ Irrigation _____ Fish Culture _____ Other: _____

If a flowing well, method of flow regulation: Valve _____ Other (describe) _____

Static Water Level: 52 feet above or below (circle one) land surface Date measured: 6-15-07

Method of Measurement (circle one) steel tape electric tape air line other: _____

Well depth: 140 Well grouted to a depth of 12 feet Type of grout (circle one): Neat Cement Bentonite Mix

Casing length: 70 feet Casing diameter: 4 inches Type of casing: PVC

Screen length: 10 feet Screen diameter: 4 inches Type of screen: SLOTED PVC

Screen slot size: .013 inches Setting depth: From 120 feet to 130 feet

Type of completion (circle all applicable): Gravel packed Underreamed Telescoped Open hole Natural Development

Other (describe): _____

Top of lap pipe or reduction in casing: None feet. *If telescoped or more than one screen, describe on next page*


RECEIVED
JUL 09 2007
BY: OLWR

N-55

The sketch below only required for water wells

If well telescopes, show depths on sketch.

Ground Level →

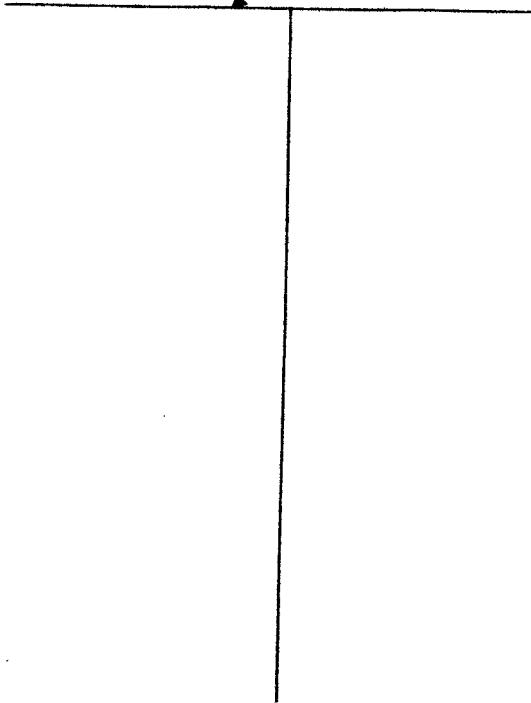


Description of formations encountered must be provided for all wells and boreholes, unless specifically exempted by regulations

Description of Formations Encountered	From (depth)	To (depth)
	Ground Level	
DIRT	0	10
R/SAND	10	30
Red CLAY		
SAND	30	60
Mix d w/CLAY		
SAND	60	110
w/SAND	110	180

If more than one screen, show location of each on sketch

Sketch the property layout and include the following: 1) the well location; 2) any permanent structures on the property that may aid in locating the well; 3) any roads, power lines, or other items that may aid in locating the property and the well; 4) a north arrow.

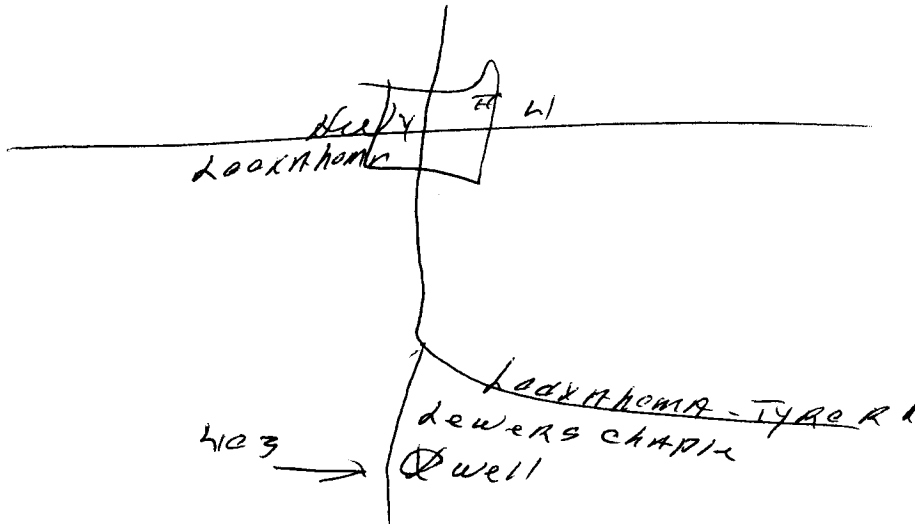

Landowner Name: JOHN SMITH

I certify that the well/borehole was drilled, constructed, and completed in accordance with all applicable requirements of the Mississippi Department of Environmental Quality and the Mississippi Department of Health regulations, if applicable, and all relevant laws.

FRANK LANGFORD C-682 6-15-07
 Print Name of Responsible Licensee and License No. Date

Frank Langford
 Signature of Licensee

RECEIVED

JUL 09 2007

BY: OLWR

STATE WELL REPORT

Part 2

Pump Installer's Completion Report
 Mississippi Department of Environmental Quality
 Office of Land and Water Resources
 P.O. Box 10631
 Jackson, MS 39289-0631
 (601)961-5210
 (601)354-6938 (fax)

County: TATE
 Permit #: _____
 Driller: F. LANGFORD
 Date completed: 6-15-07
Copy information from block on Part 1

For Office Use Only:

Aquifer: _____
 Well #: N-55
 Elevation: _____

This part of the report must be completed by a licensed water well contractor or a licensed pump installer. A copy of Part 1 of the report must be attached and both parts filed with the Department at the above address within 30 days of well completion.

Well Owner Information	Well Location
Owner Name: <u>DON SMITH</u>	Latitude: _____ Longitude: _____
Mailing Address: <u>1103 HEWERS CHAPEL</u>	Method of Lat/Long (check one): <u>Conventional Survey</u>
<u>SENATEGA MS</u>	USGS quad _____, Hand-held GPS _____, Survey-grade GPS _____
City State Zip Code	_____ 1/4 _____ 1/4 Sec <u>2 T 6 S R 6 W</u>
Telephone No. () _____	Distance Direction Nearest Town
	<u>3</u> Miles <u>SW</u> of <u>HEATHTONIA</u>

Pump Type Circle one	Power Type Circle one
Air Lift Jet <u>Submersible</u>	Diesel Engine Gasoline Engine Natural Gas
Bucket Piston Turbine	<u>Electric Motor</u> Hand Tractor PTO
Centrifugal Rotary Flowing Well	Windmill Other (specify): _____
Other (specify): _____	Horse Power Rating of Motor: <u>3/4</u>
Date Pump Installed: <u>6-15-07</u>	Setting Depth: <u>120</u> feet
Rated Pump Capacity: <u>12+</u> Gallons Per Minute	Number of Stages: <u>12</u>

Pump Test Data	Method of Measuring Water Level Circle one
Date Well Tested: <u>6-15-07</u>	Air Line Electric Measuring Line <u>Steel Tape</u>
Static Water Level (A): <u>50</u> Feet Below Land Surface	Other (specify): _____
Pumping Water Level (B): <u>50</u> Feet Below Land Surface	For flowing well, measured shut in head: _____ feet
Drawdown [(B) - (A)]: <u>0</u> Feet Below Land Surface	Well yielded <u>12+</u> GPM with a drawdown of
Test Pumping Rate: <u>12+</u> Gallons Per Minute	<u>0</u> feet after <u>4</u> hours of pumping
Duration of Pump Test (minimum 4 hours): <u>4</u> hours	

I HEREBY CERTIFY that the above statements are true to the best of my knowledge.

F. LANGFORD 0-622 Frank Langford
 Print Name of Pump Installer and License No. (if applicable) Signature of Pump Installer

RECEIVED
 JUL 09 2007
 BY: OLWR