	State W	ell Report		
County: Tate		Driller's Log	For Office Use Only:	
	Mississippi Department of Environmental Quality		Aquifer:	
Permit #:	Office of Land and Water Resources P.O. Box 2309		Well #: N67	
Driller: Janes w Mason	Jackson, MS 39225		L. S. Elevation:	
Date drilling completed: 2-9-13		961- 5210 1 5238 (fox)		
	(001)90	1- 5228 (fax)	E-log #:	
State Law requires that this repor	t be prepared by the lic	ense holder responsible for	the work and filed with the	
Department at the above address				
Information on Well C (Landowner if borehole is not fo			prehole Location	
	,	Latitude: 34 . 34 . 04	_" Longitude: <u>\$9°50</u> ,,"	
	$\frac{(Landowner if borehole is not for a water well)}{(Landowner if borehole is not for a water well)}$ Latitude: $\frac{34 \circ 34}{01}$ Latitude: $\frac{34 \circ 34}{01}$ Method of Lat/Long (circle on		ne): Conventional Survey, 교식	
Mailing Address: 1589 Por-	ree la	USGS quad, Hand-held	I GPS, Survey-grade GPS	
		NW 1/ NW 1/ Sec 16	Twn 65 Rng 68	
<u>Senatobia</u> <u>r</u> City Sta	ns 38668	NE		
City Star	te Zip Code	Distance Direction	of springfield	
Telephone No. (663) 388-343	9		<u></u>	
	Well / Bore	hole Data		
Date drilling started: $\frac{3-9-13}{2}$ Date dr			Hale diamatan (0.3/4	
Date drilling started: 2^{-9-15} Date dri	illing completed: $3 - 1 - 1$	Hole depth:	Hole diameter:	
Location of the source of any surface wate Method of dosing and volume of Chloring	er used for drilling: <u> </u>	A lopment: vA		
Logs run (circle all applicable): No. log run Name of organization running log(s):	A Electric Gamma Ray		Other:	
Purpose of borehole (check one): Water W	ellGeotechnical/Geol	ogical Investigation Ground	d Source Heat Pump	
Seismic	SurveyOther (<i>describe</i>	of ant		
If drilling is not related	to water well construction	on, skip the remainder of this b	lock	
Purpose of Well (check one): Home <u>I</u>	ndustrial Public Supply	yIrrigationFish Culture	Other:	
If a flowing well, method of flow regulation				
Static Water Level: <u>60</u> feet at				
Method of Measurement (circle one) steel tape electric tape air line other: String weight				
Well depth: 125 Well grouted to a depth of 10 feet Type of grout (circle one): Neat Cement Bentonite Mix				
Casing length: <u>115</u> feet Casin	ng diameter:	inches Type of casing:	puc	
Screen length: <u>10</u> feet Screen diameter: <u>4</u> inches Type of screen: $\rho J C$				
Screen slot size: <u>010</u> inches	Setting depth: From _	115 feet to	125 feet	
Type of completion (circle all applicable):	Gravel packed Under	rreamed Telescoped Oper	hole Natural Development	
	Other (describe):	лА		
Top of lap pipe or reduction in casing:	NA feet. If te	lescoped or more than one scre	een, describe on next page	
<u></u>			Form: OLWR SWR 14 0400	
			MAR 0 8 2013	

٠

`~,

BY: OLWR

The sketch below only required for water wells


If well telescopes, show depths on sketch.

Ground Level_

evel	Description of Formations Encountere	d From (depth)	l'o (depth)
F	- clay dirt	Ground Level	35
	white souch	92	135
			L
	·		
			1
			ļ

Description of formations encountered must be provided for all wells and boreholes, unless specifically exempted by regulations

If more than one screen, show location of each on sketch

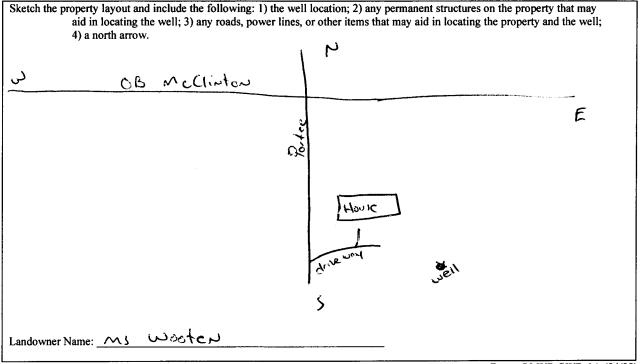

Form: OLWR-SWR-1A (04/08)

I certify that the well/borehole was drilled, constructed, and completed in accordance with all applicable requirements of the Mississippi Department of Environmental Quality and the Mississippi Department of Health regulations, if applicable, and state laws.

3-6-13 Jones W. Mason 0-620 sw.Marge JEIVED Signature of Licensee Date

Print Name of Responsible Licensee and License No.

MAR 6 8 2013

BYCHWA

	STATE WELL REPORT	
County: Tate	Part 2 Pump Installer's Completion Report	For Office Use Only:
Permit #:	Mississippi Department of Environmental Quality Office of Land and Water Resources	Aquifer:
Driller: Janes U. Mason Date completed: 2-9-13	P.O. Box 2309 Jackson, MS 39225	Well #:N67
Copy information from block on Part 1	(601)961-5210 (601)961-5228 (fax)	Elevation:

AND MUDIT DEDO

This part of the report must be completed by a licensed water well c					
report must be attached and both parts filed with the Department at the above address within 30 days of well completion.					
Well Owner Information	Well Location				

Owner Name: MJ	woot	e~		
Mailing Address:	1589	port	٩٢	19
	otobia	M5	3	 ૪৬৯૪
Ci		State	Z	ip Code

Telephone No. (662) 288 - 3432

· · · .

Γ

	Pump Typ Circle one			Power Type Circle one	
Air Lift	Jet	Submersible	Diesel Engine	Gasoline Engine	Natural Gas
Bucket	Piston	Turbine	Electric Motor	Hand	Tractor PTO
Centrifugal	Rotary	Flowing Well	Windmill	Other (specify):	
Other (specify):			Horse Power Ratin	g of Motor:3	14
Date Pump Installe	d: 3-9-1	3	Setting Depth:	80	feet
Rated Pump Capac	_	Gallons Per Minute	Number of Stages:	8	

Pump Test Data	Method of Measuring Water Level Circle one		
Date Well Tested:)- 7 - 13 Static Water Level (A): 60 Feet Below Land Surface Pumping Water Level (B): Feet Below Land Surface	Air Line Electric Measuring Line Steel Tape Other (specify): <u>String weignt</u>		
Pumping water Level (B):	For flowing well, measured shut in head:		
Duration of Pump Test (minimum 4 hours): <u> </u>	feet after $$ $$ hours of pumping		

I LIEDERY CERTIEV #	at the above statements are true to	to the best of my knowledge.	
		\frown	
Print Name of Pump Inst	taller and License No. (if applicable	ble) Signature of Pump Installer	RECEIVED
		Form: OI	LWR-SWR-1B (04/08)

MAR 0 8 2013

BY OLWA