

Date
 N 200
 10-16-75

MISSISSIPPI
 BOARD OF WATER COMMISSIONERS
 416 North State Street
 Jackson, Mississippi 39201

WATER WELL DRILLERS LOG

10-16 1975 Hicks Well Co. State
 date well completed firm name county well located

LANDOWNER: T. Leon
 Paulkman, - Rt 1 Box 330
 Senatobia, Miss
 (mailing address)


description of formations encountered	from	to
Red clay + Gravel	0	15
Gravel	15	45
Gravel + white sand	45	60
white sand	60	120

WELL LOCATION:
 sec. 7 T 6 N R 6 E 15E
 5 miles SE of ^{15E} ~~Ray~~ ^{Ray} town
 (distance) (direction) (nearest town)

WELL PURPOSE: drinking
 (home, irrigation, municipal, industrial)

- WELL COMPLETION DATA:
- (1) diameter (inches) 4 1/2 in
 - (2) total depth (feet) 120
 - (3) static water level (feet) 80 below above top of ground.
 - (4) casing Galvaste, 120,
 (material) (depth)
 - _____ If telescope see back.
 (size)
 - (5) screen 4 ft, 113
 (length) (depth to top)
 - 4 in, Gravel
 (size) (material)
 - (6) pump 1/2 10
 (HP) (yield gpm)
 - 220
 (type power)
 - (7) electric log no
 (yes or no)
 - _____ (organization running log)
 - (8) how well bottom plugged cap

DRILLERS REMARKS:

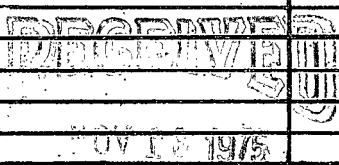

If well telescopes please sketch and show depths.

GROUND LEVEL

X			

SECTION 7

Please indicate well location X.

ADDITIONAL INFORMATION

If more than one screen,
show locations of each on sketch.