

TATE
 N 2003
 1-6-76

MISSISSIPPI
 BOARD OF WATER COMMISSIONERS
 416 North State Street
 Jackson, Mississippi 39201

15E

WATER WELL DRILLERS LOG

1-6-76 date well completed Hicks Well Co firm name Tate county well located

LANDOWNER: James Mapels
 RT-1 Senatobia
 MISS. (mailing address)

description of formations encountered	from	to
Red clay	0	10
white clay	10	30
white clay & sand	30	70
white sand	70	133

WELL LOCATION:
 sec 6 T 10 N R 6 E
 ? 1/4 miles S.E. of Senatobia
 (distance) (direction) (nearest town)

WELL PURPOSE: Home
 (home, irrigation, municipal, industrial)


- WELL COMPLETION DATA:
- (1) diameter (inches) 4"
 - (2) total depth (feet) 133
 - (3) static water level (feet) 60 below above top of ground.
 - (4) casing PVC 126 (material) (depth) (size) if telescope see back.
 - (5) screen 7' 7' (length) (depth to top) 4" inside thread (size) (material)
 - (6) pump 3/4 (HP) 10 (yield gpm) 220 Ele (type power)
 - (7) electric log Yes (yes or no) (organization running log)
 - (8) how well bottom plugged Caps

DRILLERS REMARKS:

RECEIVED
 FEB 18 1976

If well telescopes please sketch and show depths.

GROUND LEVEL

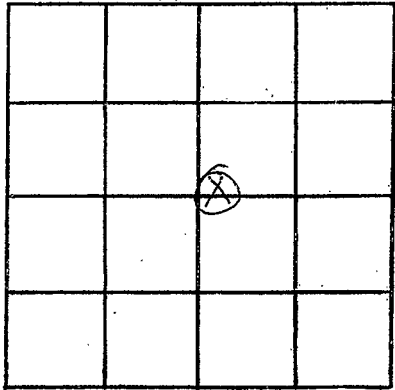

SECTION 6

Please indicate well location X.

ADDITIONAL INFORMATION

If more than one screen,
show locations of each on sketch.