

Tate  
 N 2000  
 11-19-76

MISSISSIPPI  
 BOARD OF WATER COMMISSIONERS  
 416 North State Street  
 Jackson, Mississippi 39201

WATER WELL DRILLERS LOG

11-19-76 date well completed  
 15E High Well Co. firm name  
 Tate county well located

LANDOWNER: Mannie Reed  
Rt. 1  
Senatobia, Miss  
 (mailing address)

description of formations encountered	from	to
Red Clay	0	20
Red Sand	20	60
Clay	60	95
White Clay + Sand	95	120
White Sand	120	147

WELL LOCATION:  
 sec. 10 T 6 N R 6 E  
3 miles SE of Senatobia  
 (distance) (direction) (nearest town)

WELL PURPOSE: Home  
 (home, irrigation, municipal, industrial)

- WELL COMPLETION DATA:
- (1) diameter (inches) 4
  - (2) total depth (feet) 147
  - (3) static water level (feet) 100 below above top of ground.
  - (4) casing PVC 147  
 (material) (depth)
  - (size) If telescope see back.
  - (5) screen 7' 140'  
 (length) (depth to top)
  - 4'  
 (size) Shavelt PVC  
 (material)
  - (6) pump 1/2 10  
 (HP) (yield gpm)
  - 220V  
 (type power)
  - (7) electric log No  
 (yes or no)
  - (organization running log)
  - (8) how well bottom plugged cap


RECEIVED

JAN 5 1977

DRILLERS REMARKS:

If well telescopes please sketch and show depths.

GROUND LEVEL

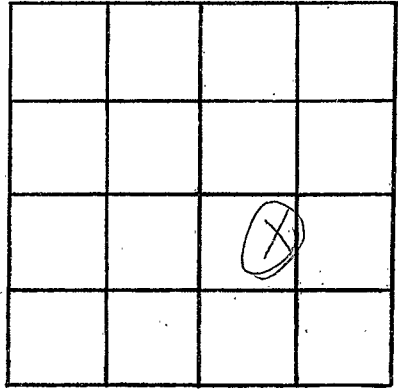

SECTION 10

Please indicate well location X.

ADDITIONAL INFORMATION

If more than one screen,  
show locations of each on sketch.