

TATE
 N 2007
 3-17-77

MISSISSIPPI
 BOARD OF WATER COMMISSIONERS
 416 North State Street
 15E Jackson, Mississippi 39201

WATER WELL DRILLERS LOG

3-17 1977 date well completed
 Harris Bros. firm name
 Tate county well located

LANDOWNER: Bobby Strickland
 Rt. 1 Box 212
 Senatobia
 (mailing address)

WELL LOCATION:
 sec. 6 T. 6 N R. 6 E
 1 1/2 miles W of Senatobia
 (distance) (direction) (nearest town)

WELL PURPOSE: none
 (home, irrigation, municipal, industrial)

- WELL COMPLETION DATA:
- (1) diameter (inches) 4
 - (2) total depth (feet) 130
 - (3) static water level (feet) 90 ^{below} _{above} top of ground.
 - (4) casing Plastic, 123' (material) (depth)
 4" (size) if telescope see back.
 - (5) screen 7' 123' (length) (depth to top)
 008 Plastic (size) (material)
 - (6) pump 3/4 10 (HP) (yield gpm)
 elec (type power)
 - (7) electric log no (yes or no)
 (organization running log)
 - (8) how well bottom plugged solid


description of formations encountered	from	to
top soil	0	15
white clay	15	40
clay + sand	40	115
coarse sand	115	130

DRILLERS REMARKS:

RECEIVED
 SEP 30 1977
 MISS. BD. OF WATER COMMISSIONERS

If well telescopes please sketch and show depths.

GROUND LEVEL

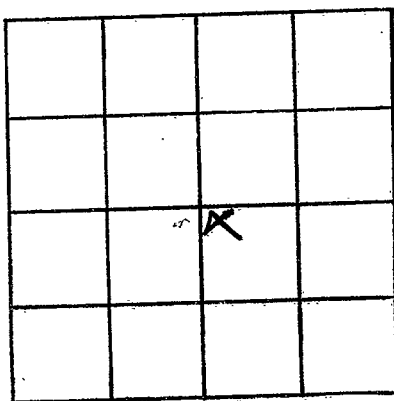

SECTION b

Please indicate well location X.

ADDITIONAL INFORMATION

If more than one screen, show locations of each on sketch.