

TATE
 N 2508
 4-14-77

MISSISSIPPI
 BOARD OF WATER COMMISSIONERS
 416 North State Street
 156 Jackson, Mississippi 39201

WATER WELL DRILLERS LOG

4-14-1977 ^{W.A. Mason} ~~Water Well Co.~~ ^{Tate}
 date well completed firm name county well located

LANDOWNER:

Charles Garrett
 P.O. - Senatobia Miss.
 (mailing address)

description of formations encountered

from to

clay sect to		20
Red clay	20	30
gravel	30	55
clay	55	60
white sand	60	145

WELL LOCATION:

sec. 10 T. 6 N. R. 6 E.
 1/2 miles SE of Longsharrow
 (distance) (direction) (nearest town)

WELL PURPOSE: HOME
 (home, irrigation, municipal, industrial)

WELL COMPLETION DATA:

- (1) diameter (inches) 4"
- (2) total depth (feet) 145'
- (3) static water level (feet) 75' below top of ground.
- (4) casing Plasto, 135'
 (material) (depth)
4" if telescope see back.
 (size)
- (5) screen 10', 135'
 (length) (depth to top)
4", Plasto
 (size) (material)
- (6) pump 3/4, 1.0
 (HP) (yield gpm)
electric
 (type power)
- (7) electric log No
 (yes or no)

(organization running log)

(8) how well bottom plugged cap


DRILLERS REMARKS:

RECEIVED
 JUL 7 - 1977

MISS. BB. OF WATER COMMISSIONERS

If well telescopes please sketch and show depths.

GROUND LEVEL

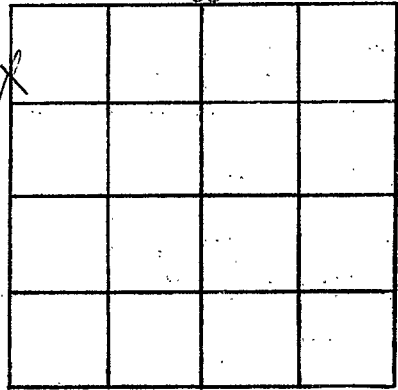

SECTION 10

Please indicate well location X.

ADDITIONAL INFORMATION

If more than one screen, show locations of each on sketch.