

TATE  
 N 2010  
 6-8-77

MISSISSIPPI  
 BOARD OF WATER COMMISSIONERS  
 416 North State Street  
 Jackson, Mississippi 39201

WATER WELL DRILLERS LOG

6-8 1977 Pick Well Co. Tate  
 date well completed firm name county well located

LANDOWNER: Andrew Bradley  
 Rt. 1  
 Senatobia, Ms.  
 (mailing address)

description of formations encountered	from	to
Red Clay	0	20
<del>Red Clay</del>		
Red Clay + sand	20	60
Red Sand	60	90
Loophole White Sand	90	150

WELL LOCATION:  
 sec. 12 T 6 N R 6 E  
 4 miles SE of Loophole  
 (distance) (direction) (nearest town)

WELL PURPOSE: Home  
 (home, irrigation, municipal, industrial)


- WELL COMPLETION DATA:
- (1) diameter (inches) 4
  - (2) total depth (feet) 150
  - (3) static water level (feet) 120 below above top of ground.
  - (4) casing PVC 150 (material) (depth)
  - (size) If telescope see back.
  - (5) screen 7' 143 (length) (depth to top)
  - 4" gravel type (size) (material)
  - (6) pump 1/2 10 (HP) (yield gpm)
  - 220V (type power)
  - (7) electric log No (yes or no)
  - (organization running log)
  - (8) how well bottom plugged Cap

DRILLERS REMARKS:

RECEIVED  
 JUL 14 1977  
 MISS. BD. OF WATER COMMISSIONERS

If well telescopes please sketch and show depths.

GROUND LEVEL

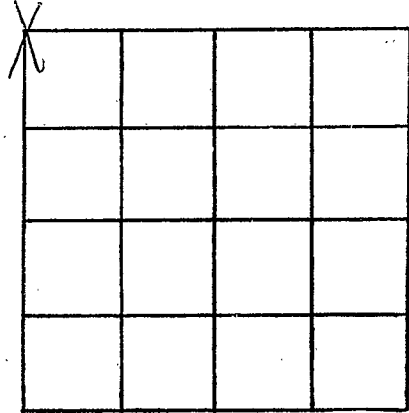

SECTION 12

Please indicate well location X.

ADDITIONAL INFORMATION

If more than one screen, show locations of each on sketch.