

TATE
 N 2011
 8-11-77

MISSISSIPPI
 BOARD OF WATER COMMISSIONERS
 416 North State Street
 15E Jackson, Mississippi 39201

WATER WELL DRILLERS LOG

8-11-77 19 date well completed Hicks well co firm name TATE county well located

LANDOWNER: James S Hill
 RT-1 Senatobia Miss
 (mailing address)

description of formations encountered	from	to
RC	0	10
Red sand & gravel	10	60
R-S	60	90
US	90	127

WELL LOCATION:
 sec. 18 T. 6 N R. 6 E
 4 miles NE of Gravel Springs
 (distance) (direction) (nearest town)

WELL PURPOSE: Home
 (home, irrigation, municipal, industrial)


- WELL COMPLETION DATA:
- (1) diameter (inches) 4"
 - (2) total depth (feet) 127
 - (3) static water level (feet) 8.5 below top of ground.
 - (4) casing PVC, 127 (material) (depth)
 - (size) if telescope see back.
 - (5) screen 7' 7' (length) (depth to top)
 - 4" inside Rock (size) (material)
 - (6) pump 1/2 10 (HP) (yield gpm)
 - Elec (type power)
 - (7) electric log NO (yes or no)
 - (organization running log)
 - (8) how well bottom plugged C&P

DRILLERS REMARKS:

RECEIVED
 AUG 19 1977
 MISS. BD. OF WATER COMMISSIONERS

If well telescopes please sketch and show depths.

GROUND LEVEL

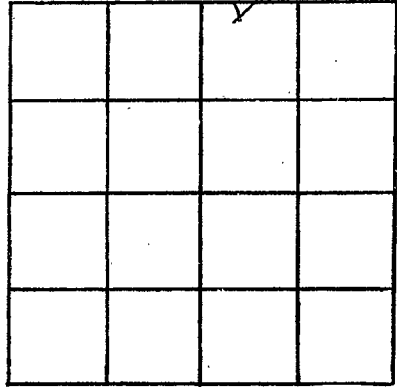

SECTION _____

Please indicate well location X.

ADDITIONAL INFORMATION

If more than one screen,
show locations of each on sketch.