

Date
 N 2012
 10/26/77

MISSISSIPPI
 BOARD OF WATER COMMISSIONERS
 416 North State Street
 15E Jackson, Mississippi 39201

WATER WELL DRILLERS LOG

10/26 1977 Hick Well Co. Tate
 date well completed firm name county well located

LANDOWNER: J. C. Hick
Rt 1
Senatobia, Ms.
 (mailing address)

description of formations encountered	from	to
<u>Red Clay</u>	<u>0</u>	<u>15</u>
Red Clay Red Clay Red Clay	<u>15</u>	<u>60</u>
<u>white sand + clay</u>	<u>60</u>	<u>174</u>
<u>white sand</u>	<u>174</u>	<u>200</u>

WELL LOCATION:
 sec. 1 T. 6 N. R. 6 E.
2 miles E of Senatobia
 (distance) (direction) (nearest town)

WELL PURPOSE: Home
 (home, irrigation, municipal, industrial)


WELL COMPLETION DATA:
 (1) diameter (inches) 4
 (2) total depth (feet) 200
 (3) static water level (feet) 20 below above top of ground.
 (4) casing PVC, 200,
 (material) (depth)
 (size) if telescope see back.
 (5) screen 7ft, 193
 (length) (depth to top)
4", gravel type
 (size) (material)
 (6) pump 1/2 10
 (HP) (yield gpm)
220V
 (type power)
 (7) electric log Y
 (yes or no)
 (organization running log)
 (8) how well bottom plugged Clay

DRILLERS REMARKS:

RECEIVED
 NOV - 7 1977
 MISS. BD. OF WATER COMMISSIONERS

If well telescopes please sketch and show depths.

GROUND LEVEL

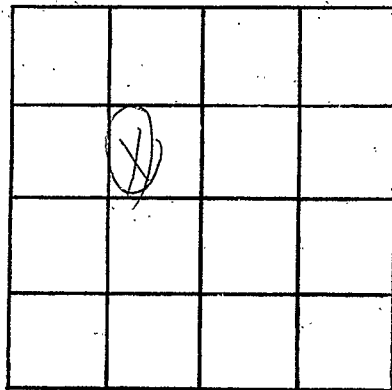

SECTION 1

Please indicate well location X.

ADDITIONAL INFORMATION

If more than one screen, show locations of each on sketch.