

Date
 N 2013
 8-11-77

MISSISSIPPI
 BOARD OF WATER COMMISSIONERS
 416 North State Street
 156 Jackson, Mississippi 39201

WATER WELL DRILLERS LOG

8-11-77 19 Hicks well 00 TATE
 date well completed firm name county well located

LANDOWNER: Bernice Evans
 RT-1
 Senatobia Miss
 (mailing address)

description of formations encountered	from to	
Red clay	0	30
Red sand	30	60
W.S.	60	120

WELL LOCATION:
 4 miles NE COMOD sec 18 T-6 N R-6 E
 (distance) (direction) (nearest town)

WELL PURPOSE: Home
 (home, irrigation, municipal, industrial)


- WELL COMPLETION DATA:
- (1) diameter (inches) 4"
 - (2) total depth (feet) 123
 - (3) static water level (feet) 33 below above top of ground.
 - (4) casing pvc (material), 123 (depth)
 (size) if telescope see back.
 - (5) screen 7" (length), 7 (depth to top)
 4 (size), Inside Gravel (material)
 - (6) pump 1/2 (HP), 10 (yield gpm)
 Elec (type power)
 - (7) electric log NO (yes or no)
 (organization running log)
 - (8) how well bottom plugged Cap

DRILLERS REMARKS:

RECEIVED
 AUG 19 1977
 MISS. BU. OF WATER CONTROL

If well telescopes please sketch and show depths.

GROUND LEVEL

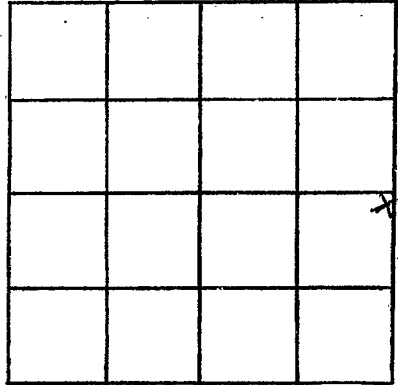

SECTION _____

Please indicate well location X.

ADDITIONAL INFORMATION

If more than one screen,
show locations of each on sketch.