

TATE
 N 2014
 3-30-78

MISSISSIPPI
 BOARD OF WATER COMMISSIONERS
 416 North State Street
 Jackson, Mississippi 39201

WATER WELL DRILLERS LOG

3-30 1978 date well completed
 H. H. H. Well Co firm name
 Tate county well located

LANDOWNER: Lucius Davis
Refil
Senatobia, Mo. 38668
 (mailing address)

description of formations encountered	from	to
red clay	0	15
Red clay + sand	15	90
White sand	90	150

WELL LOCATION:
 sec. 16 T. 6 N. R. 6 E
3 miles S of Leopold
 (distance) (direction) (nearest town)

WELL PURPOSE: Home
 (home, irrigation, municipal, industrial)

WELL COMPLETION DATA:

(1) diameter (inches) 4"
 (2) total depth (feet) 150
 (3) static water level (feet) 80 below top of ground.
 (4) casing PVC, 150
 (material) (depth)
 (size) if telescope see back.
 (5) screen 7', 143
 (length) (depth to top)
4" gravel type
 (size) (material)
 (6) pump 42 10
 (HP) (yield gpm)
220V
 (type power)
 (7) electric log No
 (yes or no)
 (organization running log)
 (8) how well bottom plugged Cap

RECEIVED


MAY 4 1978

WATER COMM

DRILLERS REMARKS:

If well telescopes please sketch and show depths.

GROUND LEVEL

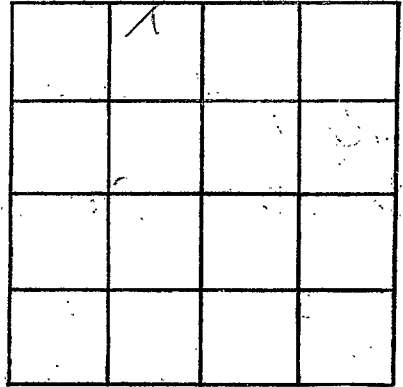

SECTION 16

Please indicate well location X.

ADDITIONAL INFORMATION

If more than one screen,
show locations of each on sketch.