

TATE
 N 2015
 6/7/78

MISSISSIPPI
 BOARD OF WATER COMMISSIONERS
 416 North State Street
 Jackson, Mississippi 39201

WATER WELL DRILLERS LOG

6-7 1978 Bick Well Co Tate
 date well completed firm name county well located

LANDOWNER: Morris Malone
Ret. 1
Como, Ms.
 (mailing address)

description of formations encountered	from	to
Red Clay	0	30
Red Sand & Clay	30	120
White Sand	120	180

WELL LOCATION:
 sec. 10 T. 6 N. R. 6 E
 #2 SC miles of Leakaloon
 (distance) (direction) (nearest town)

WELL PURPOSE:
 (home, irrigation, municipal, industrial)

WELL COMPLETION DATA:

(1) diameter (inches) 4"

(2) total depth (feet) 180

(3) static water level (feet) 100 below above top of ground.

(4) casing PVC, 180,
 (material) (depth)

_____ If telescope see back.
 (size)

(5) screen 7', 173
 (length) (depth to top)

4 gravel type
 (size) (material)


(6) pump 1/2 10
 (HP) (yield gpm)

220V
 (type power)

(7) electric log No
 (yes or no)

_____ (organization running log)


(8) how well bottom plugged Cap

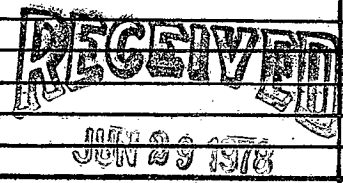

DRILLERS REMARKS:

If well telescopes please sketch and show depths.

GROUND LEVEL

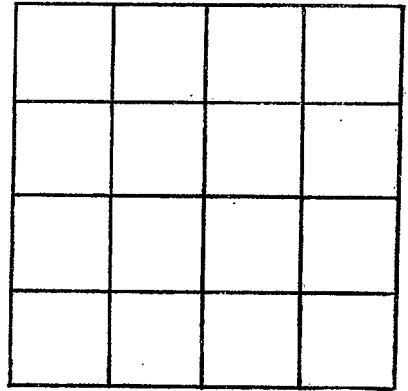

SECTION _____

Please indicate well location X.

ADDITIONAL INFORMATION

If more than one screen,
show locations of each on sketch.