

TATE
N 206
8-3-78

**MISSISSIPPI
BOARD OF WATER COMMISSIONERS**
416 North State Street
Jackson, Mississippi 39201

WATER WELL DRILLERS LOG


8-3-1978 High Well Co Tate
 date well completed firm name county well located

LANDOWNER: <u>Albert Booker</u>	description of formations encountered	from	to
<u>Rt. 1</u>			
<u>Senatobia, Ms.</u> (mailing address)	<u>Red Clay</u>	<u>0</u>	<u>10</u>
WELL LOCATION: sec. <u>2</u> T. <u>6</u> N. R. <u>6</u> E. <u>1 1/2</u> miles <u>E</u> of <u>Senatobia</u> (distance) (direction) (nearest town)	<u>Red Clay + sand</u>	<u>10</u>	<u>80</u>
WELL PURPOSE: <u>Home</u> (home, irrigation, municipal, industrial)	<u>White Sand</u>	<u>80</u>	<u>128</u>
WELL COMPLETION DATA:			
(1) diameter (inches) <u>4</u>			
(2) total depth (feet) <u>128</u>			
(3) static water level (feet) <u>40</u> below top of ground.			
(4) casing <u>PVC</u> , <u>128</u> , (material) (depth)			
_____ if telescope see back. (size)			
(5) screen <u>2'</u> , <u>121</u> (length) (depth to top)			
<u>4"</u> , <u>gravel</u> (size) (material)			
(6) pump <u>1/2</u> , <u>10</u> (HP) (yield gpm)			
<u>220V</u> (type power)			
(7) electric log <u>No</u> (yes or no)			
_____ (organization running log)			
(8) how well bottom plugged <u>Cap</u>			
DRILLERS REMARKS:			

RECEIVED
 SEP 25 1978
 MISS. BD. OF WATER COMMISSIONERS

If well telescopes please sketch and show depths.

GROUND LEVEL

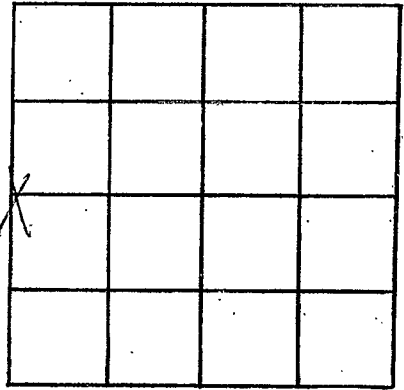

SECTION

2

Please indicate well location X.

ADDITIONAL INFORMATION

If more than one screen,
show locations of each on sketch.