

TATE
 N 207
 10-6-78

MISSISSIPPI
 BOARD OF WATER COMMISSIONERS
 416 North State Street
 Jackson, Mississippi 39201

WATER WELL DRILLERS LOG

10-6-78 date well completed High Well Co firm name Tate county well located

LANDOWNER: Leonard Reed
 description of formations encountered

	from	to
<u>Red Clay</u>	<u>0</u>	<u>25</u>
<u>Gravel</u>	<u>25</u>	<u>60</u>
<u>Sand + Gravel</u>	<u>60</u>	<u>90</u>
<u>White Clay</u>	<u>90</u>	<u>120</u>
<u>White Sand</u>	<u>120</u>	<u>155</u>

Ret. 1
 Senatobia, Ms. (mailing address)

WELL LOCATION:
 sec. 10 T. 6 N. R. 6 E.
242 miles S of Leokhana (distance) (direction) (nearest town)

WELL PURPOSE: Home
 (home, irrigation, municipal, industrial)

WELL COMPLETION DATA:

(1) diameter (inches) 4

(2) total depth (feet) 155

(3) static water level (feet) 80 below top of ground.

(4) casing PVC (material), 155 (depth),
 (size) if telescope see back.

(5) screen 7' (length), 148 (depth to top)
4" (size), gravel type (material)

(6) pump 42 (HP), 10 (yield gpm)
220V (type power)

(7) electric log No (yes or no)

(organization running log)


(8) how well bottom plugged Cap

RECEIVED
 OCT 30 1978

DRILLERS REMARKS:

If well telescopes please sketch and show depths.

GROUND LEVEL

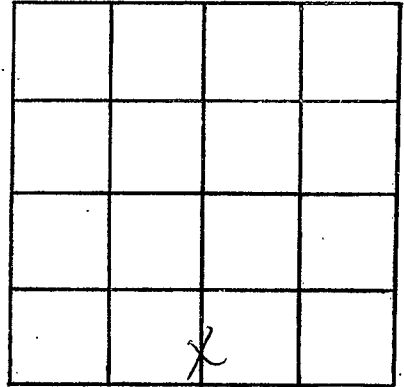

SECTION 10

Please indicate well location X.

ADDITIONAL INFORMATION

If more than one screen,
show locations of each on sketch.