

TATE  
 N 208  
 1-15-79

MISSISSIPPI  
 BOARD OF WATER COMMISSIONERS  
 416 North State Street  
 Jackson, Mississippi 39201

WATER WELL DRILLERS LOG

1-15 19 79 Hicks Well Co Tate  
 date well completed firm name county well located

LANDOWNER: Richard Burnett  
Rt. 1  
Senatobia, Ms.  
 (mailing address)

WELL LOCATION:  
 sec. 18 T 6 N R 6 E  
5  
 (distance) miles (direction) of Grand Springs (nearest town) White Sand

WELL PURPOSE: Home  
 (home, irrigation, municipal, industrial)

WELL COMPLETION DATA:  
 (1) diameter (inches) 4  
 (2) total depth (feet) 150  
 (3) static water level (feet) 80 below above top of ground.  
 (4) casing PVC, 150,  
 (material) (depth)  
 (size) If telescope see back.  
 (5) screen 7, 143  
 (length) (depth to top)  
4", gravel type  
 (size) (material)  
 (6) pump 1/2, 10  
 (HP) (yield gpm)  
220V  
 (type power)  
 (7) electric log No  
 (yes or no)

(organization running log)  
 (8) how well bottom plugged Cap


DRILLERS REMARKS:

description of formations encountered	from	to
Red clay	0	10
Red sand + gravel	10	60
White sand + clay	60	130
White sand	130	150

RECEIVED  
 FEB 2-79

If well telescopes please sketch and show depths.

GROUND LEVEL

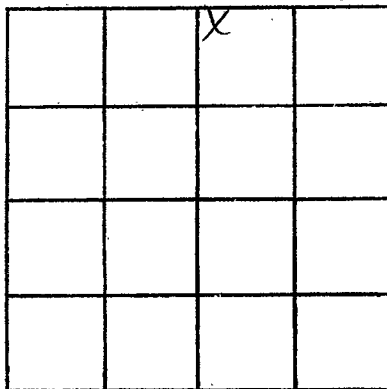

SECTION 18

Please indicate well location X.

ADDITIONAL INFORMATION

If more than one screen,  
show locations of each on sketch.