

TATE
 N 509
 04-17-79

MISSISSIPPI
 BOARD OF WATER COMMISSIONERS
 416 North State Street
 Jackson, Mississippi 39201

WATER WELL DRILLERS LOG

4/17 19 79 Nichs Well Co Tate
 date well completed firm name county well located

LANDOWNER:
Glen Moore
Rt. 1, Lumbardia, Miss.
 (mailing address)

description of formations encountered	from	to
<u>Red Clay</u>	<u>0</u>	<u>10</u>
<u>Clay & Gravel</u>	<u>10</u>	<u>50</u>
<u>Gravel & sand</u>	<u>50</u>	<u>90</u>
<u>Gravel & white sand</u>	<u>90</u>	<u>155</u>

WELL LOCATION:
 sec. 10 T. 6 N. R. 6 E
4 miles S of Georgetown
 (distance) (direction) (nearest town)

WELL PURPOSE: home
 (home, irrigation, municipal, industrial)

WELL COMPLETION DATA:

(1) diameter (inches) 4 in

(2) total depth (feet) 155

(3) static water level (feet) 110 below top of ground.

(4) casing Plastic 155 ft
 (material) (depth)

(size) if telescope see back.

(5) screen 7 ft 148 ft
 (length) (depth to top)

4 in Gravel
 (size) (material)

(6) pump 1/2 10
 (HP) (yield gpm)

220
 (type power)

(7) electric log No
 (yes or no).

(organization running log)

(8) how well bottom plugged Cap

DRILLERS REMARKS:


Miss. Board of Water Comm.

APR 26 1979

RECEIVED

If well telescopes please sketch and show depths.

GROUND LEVEL

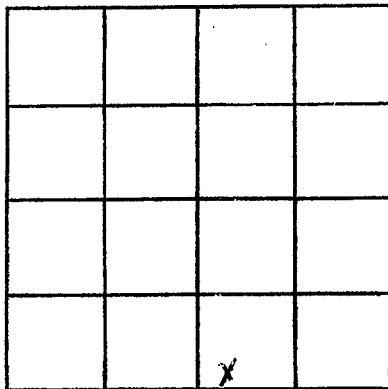

SECTION 10

Please indicate well location X.

ADDITIONAL INFORMATION

A series of horizontal lines for writing additional information.

If more than one screen, show locations of each on sketch.