

TATE
N <u>2030</u>
04-11-79

MISSISSIPPI
 BOARD OF WATER COMMISSIONERS
 416 North State Street
 Jackson, Mississippi 39201

WATER WELL DRILLERS LOG

4/11 19 79 Nichols Well Co Tate
 date well completed firm name county well located

LANDOWNER:
Lake Sanders
Rt. 1, Como Miss.
 (mailing address)

description of formations encountered	from	to
<u>Red Clay</u>	<u>0</u>	<u>40</u>
<u>Sand & Clay</u>	<u>40</u>	<u>120</u>
<u>White Clay</u>	<u>120</u>	<u>135</u>
<u>Saxapaha white sand</u>	<u>135</u>	<u>155</u>

WELL LOCATION:
 sec 14 T 6 N R 6 E
4 miles SE of Saxapaha
 (distance) (direction) (nearest town)

WELL PURPOSE: home
 (home, irrigation, municipal, industrial)

WELL COMPLETION DATA:

(1) diameter (inches) 4 in

(2) total depth (feet) 155

(3) static water level (feet) 120 below above top of ground.

(4) casing Plastic 155
 (material) (depth)

(size) if telescope see back.

(5) screen 7 ft 148 ft
 (length) (depth to top)

4/8 brass
 (size) (material)

(6) pump 1/2 10
 (HP) (yield gpm)

220
 (type power)

(7) electric log No
 (yes or no)

(organization running log)

(8) how well bottom plugged Cap.

DRILLERS REMARKS:


Miss. Board of Water Comm

APR 18 1979

RECEIVED

If well telescopes please sketch and show depths.

GROUND LEVEL

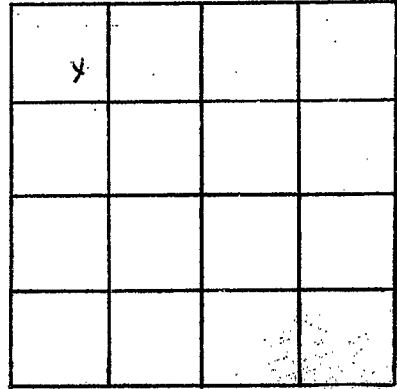

SECTION 14

Please indicate well location X.

ADDITIONAL INFORMATION

A series of horizontal lines for writing additional information.

If more than one screen, show locations of each on sketch.