

Tate  
 N 2022  
 6-21-79

MISSISSIPPI  
 BOARD OF WATER COMMISSIONERS  
 416 North State Street  
 Jackson, Mississippi 39201

WATER WELL DRILLERS LOG

6-21 19 79 Rich Well Co. Tate  
 date well completed firm name county well located

LANDOWNER:  
George Shaw  
Rt. 1, Senatobia Miss.  
 (mailing address)

description of formations encountered	from	to
<u>Red Clay</u>	<u>0</u>	<u>20</u>
<u>Red sand</u>	<u>20</u>	<u>65</u>
<u>White sand</u>	<u>65</u>	<u>140</u>

WELL LOCATION:  
 sec. 6 T. 6 N. R. 6 E.  
Gravel Springs  
 miles of (nearest town)

WELL PURPOSE: home  
 (home, irrigation, municipal, industrial)

WELL COMPLETION DATA:  
 (1) diameter (inches) 4 in  
 (2) total depth (feet) 140  
 (3) static water level (feet) \_\_\_\_\_ below above top of ground.  
 (4) casing Plastic, 140  
 (material) (depth)  
 (size) if telescope see back.  
 (5) screen 1 1/4, 133  
 (length) (depth to top)  
4 in, Gravel  
 (size) (material)  
 (6) pump 1/2, 10  
 (HP) (yield gpm)  
220  
 (type power)  
 (7) electric log No.  
 (yes or no)  
 (organization running log)  
 (8) how well bottom plugged Cap

DRILLERS REMARKS:


Miss. Board of Water Comm.

JUL 12 1979

RECEIVED

If well telescopes please sketch and show depths.

GROUND LEVEL

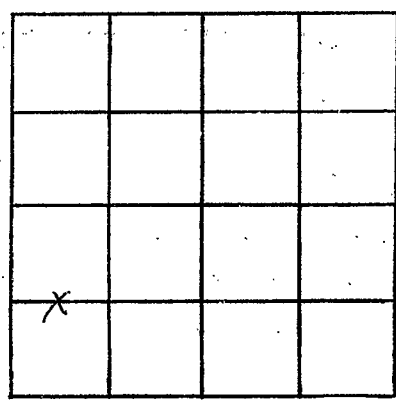

SECTION 6

Please indicate well location X.

ADDITIONAL INFORMATION

A series of horizontal lines for writing additional information.

If more than one screen, show locations of each on sketch.