

TATE  
 N 2023  
 5-15-80

MISSISSIPPI  
 BOARD OF WATER COMMISSIONERS  
 416 North State Street  
 Jackson, Mississippi 39201

WATER WELL DRILLERS LOG

5-15 1980 Nichols Well Co. Jate  
 date well completed firm name county well located

LANDOWNER:  
 Bobby J. Jago  
 Rt. 1, Senatobia  
 (mailing address)

| description of formations encountered | from | to  |
|---------------------------------------|------|-----|
| red <del>clay</del> clay              | 0    | 30  |
| red sand                              | 30   | 90  |
| white sand                            | 90   | 170 |

WELL LOCATION:  
 sec. 14 T. 10 N. R. 10 E  
 3 miles S/E of Senatobia  
 (distance) (direction) (nearest town)

WELL PURPOSE: home  
 (home, irrigation, municipal, industrial)

WELL COMPLETION DATA:

(1) diameter (inches) 4

(2) total depth (feet) 170

(3) static water level (feet) 140 below top of ground.

(4) casing plastic, 170  
 (material) (depth)

(size) if telescope see back.

(5) screen 2 ft, 1103  
 (length) (depth to top)

4 in, gravel  
 (size) (material)

(6) pump 1/2 10  
 (HP) (yield gpm)

220  
 (type power)

(7) electric log NO  
 (yes or no)

(organization running log)


(8) how well bottom plugged cap

DRILLERS REMARKS:

DEPT. OF NATURAL RESOURCES  
 BUREAU OF LAND & WATER RESOURCES  
 JUN 25 1980  
 RECEIVED

If well telescopes please sketch and show depths.

GROUND LEVEL

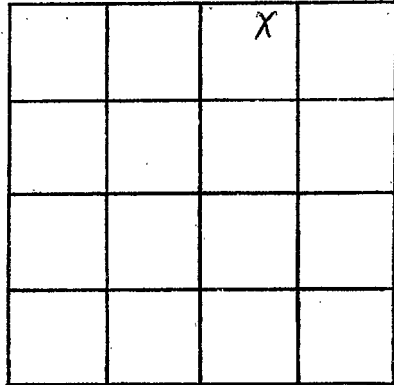

SECTION 14

Please indicate well location X.

ADDITIONAL INFORMATION

If more than one screen,  
show locations of each on sketch.