

Tate  
 N 2004  
 7-23-80

MISSISSIPPI  
 BOARD OF WATER COMMISSIONERS  
 416 North State Street  
 Jackson, Mississippi 39201

WATER WELL DRILLERS LOG

17-23 1981 date well completed  
 High Well Co. firm name  
 Tate county well located

LANDOWNER:	description of formations encountered	from	to
Jerry White Rt. 1			
Senatobia, Mo. (mailing address)	Clay	0	30
	Shovel	30	50
WELL LOCATION: sec. 15 T 6 N R 6 E 3 miles SE of Fordhook (distance) (direction) (nearest town)	Clay	50	90
	White Sand	90	170
WELL PURPOSE: (home, irrigation, municipal, industrial)			
WELL COMPLETION DATA:			
(1) diameter (inches) 4			
(2) total depth (feet) 170			
(3) static water level (feet) 120 below above top of ground.			
(4) casing PVC 170 (material) (depth)			
(size) if telescope see back.			
(5) screen 9' 163 (length) (depth to top)			
4 gravel type (size) (material)			
(6) pump 1 18 (HP) (yield gpm)			
220W (type power)			
(7) electric log No (yes or no)			
(organization running log)			
(8) how well bottom plugged Cap			
DRILLERS REMARKS:			


DEPT. OF NATURAL RESOURCES  
 BUREAU OF LAND & WATER RESOURCES

SEP 26 1980

RECEIVED

If well telescopes please sketch and show depths.

GROUND LEVEL

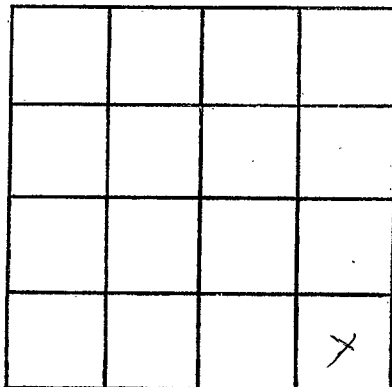

SECTION 15

Please indicate well location X.

ADDITIONAL INFORMATION

If more than one screen, show locations of each on sketch.