

MISSISSIPPI DEPARTMENT OF NATURAL RESOURCES

Bureau of Land and Water Resources

Southport Mall

P.O. Box 10631

Jackson, Mississippi 39209

WATER WELL DRILLERS LOG

HICKS WELL CO.

Rt. 1, Box 157

Senatobia, MS 38668

Tate

TATE  
N 2020  
9-2-81

9-2 19 81  
date well completed

county well located


LANDOWNER:	description of formations encountered	from	to
Part 1			
James Bradley	Red Clay	0	30
Senatobia, Mo. (mailing address)	White Clay & Sand	30	145
WELL LOCATION: sec. 1 T 6 N R 6 E 3 miles S of Bar (distance) (direction) (nearest town)	White Sand	145	215
WELL PURPOSE: Home (home, irrigation, municipal, industrial)			
WELL COMPLETION DATA:			
(1) diameter (inches) 4			
(2) total depth (feet) 215			
(3) static water level (feet) 180 below top of ground.			
(4) casing PVC, 215. (material) (depth)			
(size) If telescope see back.			
(5) screen 12, 203 (length) (depth to top)			
4" gravel & PVC (size) (material)			
(6) pump 3/4, 10 (HP) (yield gpm)			
220V (type power)			
(7) electric log No (yes or no)			
(organization running log)			
(8) how well bottom plugged CAP			
DRILLERS REMARKS:			

DEPT. OF NATURAL RESOURCES  
BUREAU OF LAND & WATER RESOURCES

SEP 24 1981  
RECEIVED

If well telescopes please sketch and show depths.

GROUND LEVEL

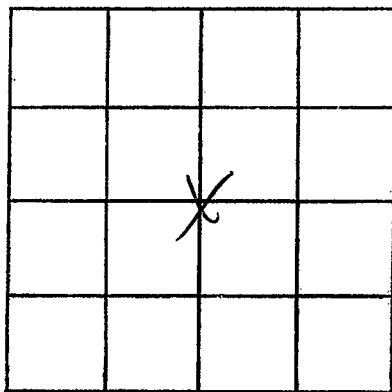

SECTION 1

Please indicate well location X.

ADDITIONAL INFORMATION

If more than one screen,  
show locations of each on sketch.