

MISSISSIPPI DEPARTMENT OF NATURAL RESOURCES

Bureau of Land and Water Resources

Southport Mall

P.O. Box 10631

Jackson, Mississippi 39209

WATER WELL DRILLERS LOG

HICKS WELL CO.

Est. 1912

Senatobia, MS 38668

Tate

Date  
N  
2007

6-23 19 83  
date well completed

county well located

LANDOWNER: Stanley M. Brooks

Box 297

Senatobia, Miss. 38668  
(mailing address)

description of formations encountered

from

to

Red clay 0 20

Red sand & gravel 20 65

White sand & clay 65 110

White sand 110 155

WELL LOCATION:

sec. 7 T 6 N R 6 E  
1 miles NE of Grand Springs  
(distance) (direction) (nearest town)

WELL PURPOSE:

Home  
(home, irrigation, municipal, industrial)

WELL COMPLETION DATA:

- (1) diameter (inches) 4
- (2) total depth (feet) 155
- (3) static water level (feet) 80 below above top of ground.
- (4) casing PVC, 155' (material) (depth)  
4" (size) if telescope see back.
- (5) screen 10' 145' (length) (depth to top)  
0.013 PVC (size) (material)
- (6) pump 1/2 10 (HP) (yield gpm)  
220V (type power)
- (7) electric log No (yes or no)

(organization running log)

(8) how well bottom plugged Cap

DRILLERS REMARKS:


DEPT. OF NATURAL RESOURCES  
BUREAU OF LAND & WATER RESOURCES

AUG 15 1983

RECEIVED

If well telescopes please sketch and show depths.

GROUND LEVEL

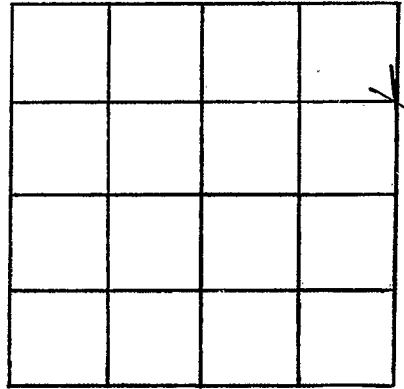

SECTION 17

Please indicate well location X.

ADDITIONAL INFORMATION

If more than one screen, show locations of each on sketch.