

MISSISSIPPI DEPARTMENT OF NATURAL RESOURCES

Bureau of Land and Water Resources

Southport Mall

P.O. Box 10631

Jackson, Mississippi 39209

WATER WELL DRILLERS LOG

HICKS WELL CO.
Rt. 1, Box 157

Senatobia, MS 38668

Jell
N
2028

8-26 19 83

date well completed

Tate

county well located

LANDOWNER: Dorothy Turner
Rt. 1
Senatobia, Ms. 38668
(mailing address)

description of formations encountered	from	to
Red Clay	0	10
Red Sand	10	50
White Sand	50	145

WELL LOCATION:
sec. 17 T. 6 N R. 6 E
1 miles E of Senatobia
(distance) (direction) (nearest town)

WELL PURPOSE: Home
(home, irrigation, municipal, industrial)

- WELL COMPLETION DATA:
- (1) diameter (inches) 4
 - (2) total depth (feet) 145
 - (3) static water level (feet) 60 ^{below} ~~above~~ top of ground.
 - (4) casing PVC, 145 (material), (depth)
4" (size) if telescope see back.
 - (5) screen 10, 135 (length), (depth to top)
1 1/2 (size), PVC (material)
 - (6) pump 1/2, 10 (HP), (yield gpm)
2208 (type power)
 - (7) electric log No (yes or no)
(organization running log)
 - (8) how well bottom plugged Sand Shark

DEPT. OF NATURAL RESOURCES
BUREAU OF LAND & WATER RESOURCES


SEP 22 1983

RECEIVED

DRILLERS REMARKS:

If well telescopes please sketch and show depths.

GROUND LEVEL

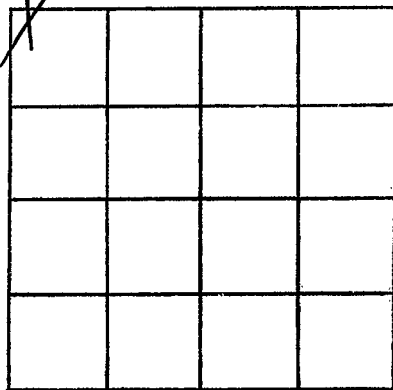

SECTION 17

Please indicate well location X.

ADDITIONAL INFORMATION

If more than one screen,
show locations of each on sketch.